

401 WILSHIRE

SUITE 350 | 20,675 RSF

SANTA MONICA




AS-BUILT CONFIGURATION

OFFICES:	10
CONFERENCE ROOM:	4
RECEPTION:	1
KITCHEN:	1
IT ROOM:	1
PRIVATE RESTROOM:	1

NOT TO SCALE

FURNITURE NOT INCLUDED

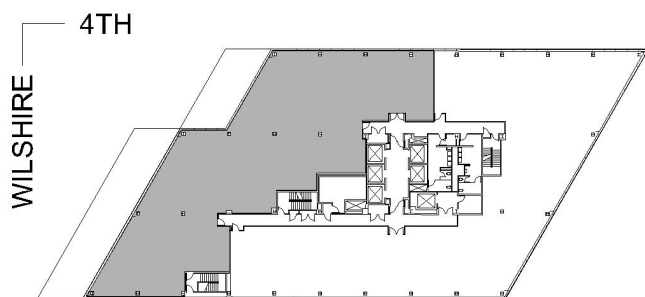

For more information, please contact:

310.255.7777

leasing@douglasemmett.com

**Douglas
Emmett**