



55

HARBOR COURT - OFFICE

SUITE 2110 | 2,678 RSF

HONOLULU

MERCHANT STREET

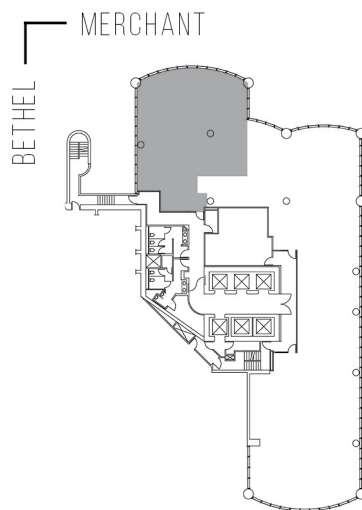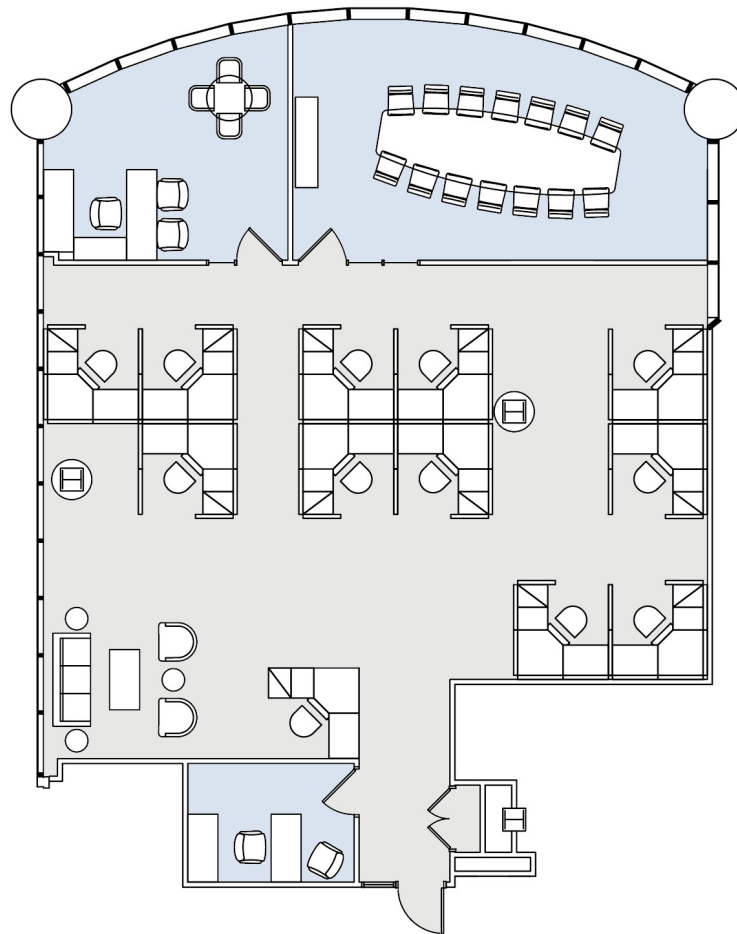

AS-BUILT CONFIGURATION

OFFICES:	2
CONFERENCE ROOM:	1
STORAGE:	1

NOT TO SCALE
FURNITURE NOT INCLUDED

For more information, please contact:

310.255.7777

leasing@douglasemmett.com

**Douglas
Emmett**