

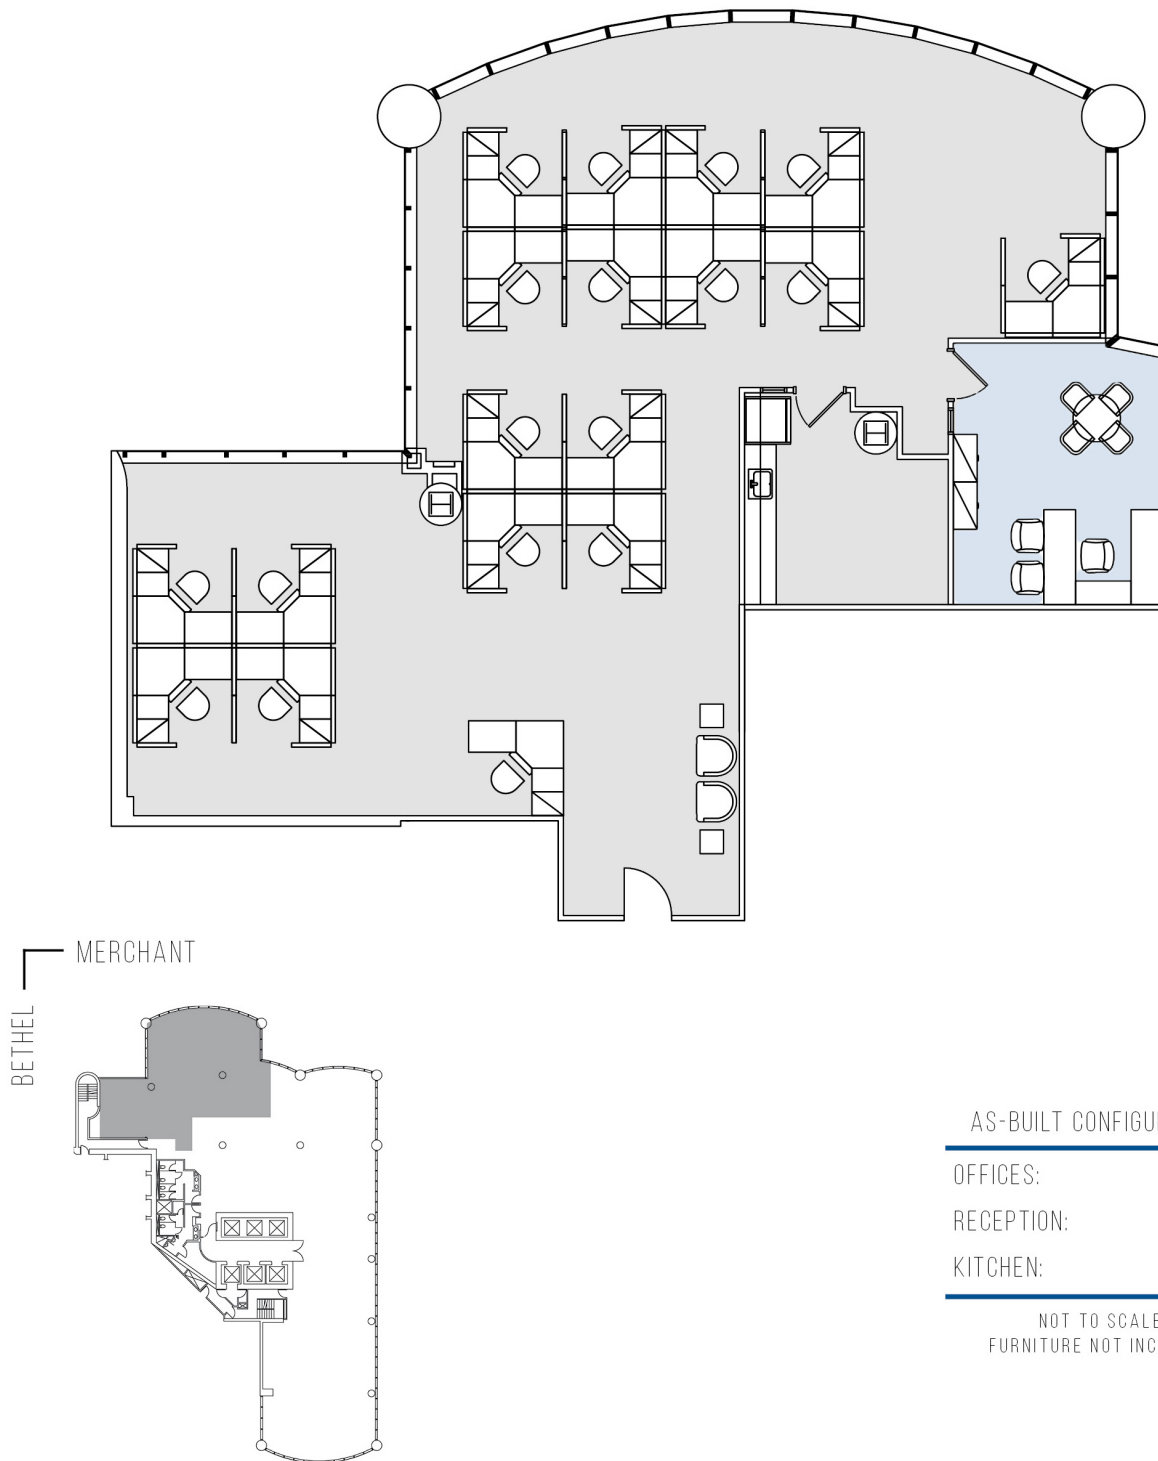
55

HARBOR COURT - OFFICE

SUITE 1560 | 2,949 RSF

HONOLULU

MERCHANT STREET

AS-BUILT CONFIGURATION

OFFICES:	1
RECEPTION:	1
KITCHEN:	1

NOT TO SCALE
FURNITURE NOT INCLUDED

For more information, please contact:

310.255.7777

leasing@douglasemmett.com

**Douglas
Emmett**