
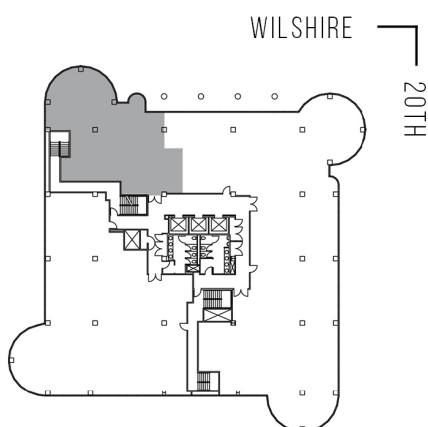


2001 WILSHIRE

SUITE 250 | 2,853 RSF

SANTA MONICA

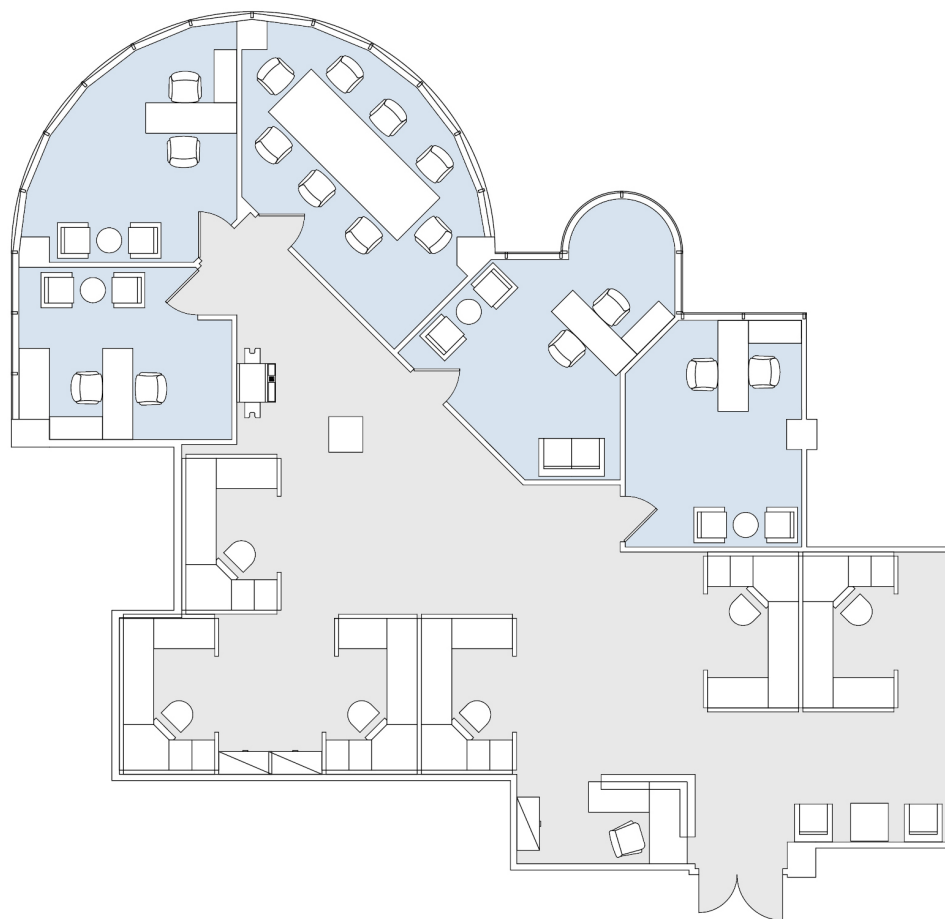

AS-BUILT CONFIGURATION

| | |
|------------------|---|
| OFFICES: | 4 |
| CONFERENCE ROOM: | 1 |
| RECEPTION: | 1 |
| OPEN OFFICE: | 1 |

ADJUSTED FOR SOCIAL DISTANCING
NOT TO SCALE
FURNITURE NOT INCLUDED

For more information, please contact:

310.255.7777

leasing@douglasemmett.com

**Douglas
Emmett**