
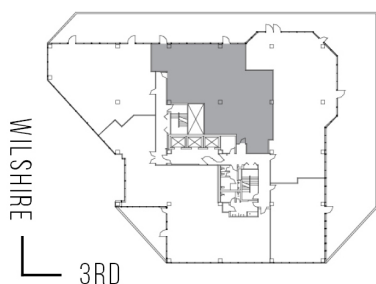


# 233 WILSHIRE

SUITE 200 | 2,935 RSF

SANTA MONICA

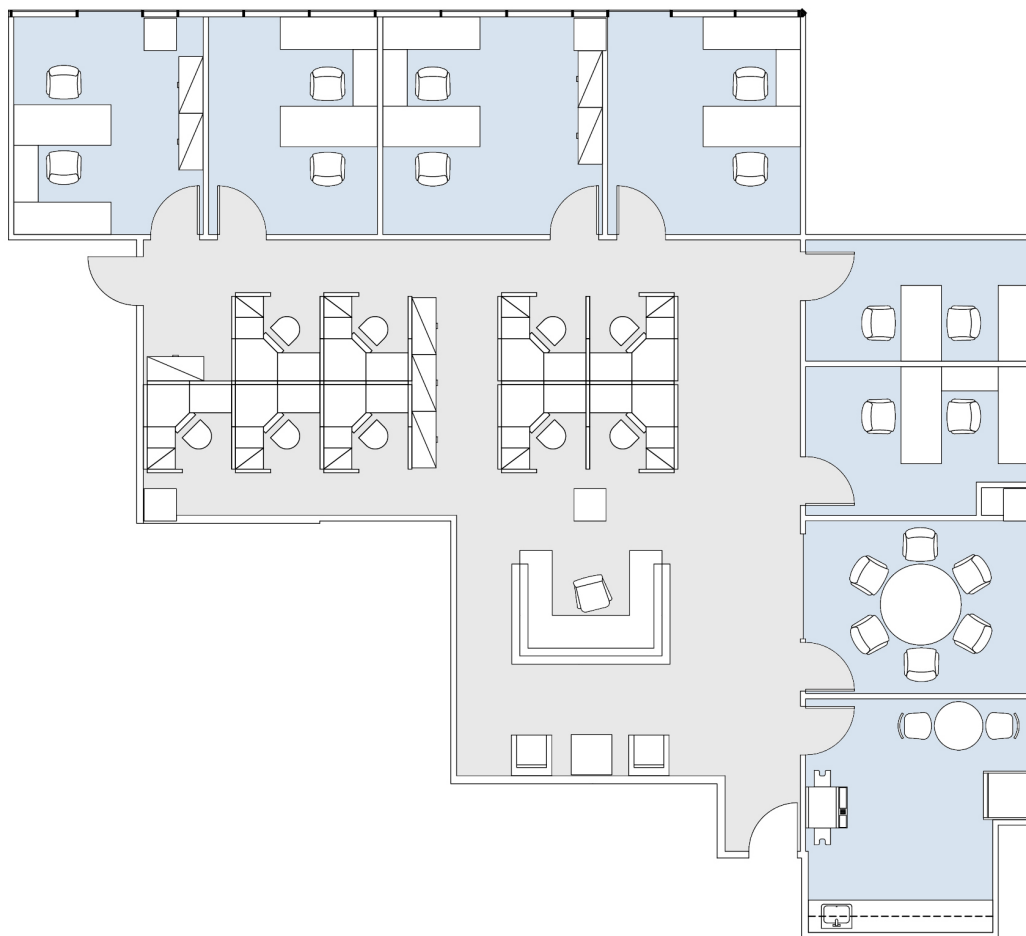

## AS-BUILT CONFIGURATION

OFFICES:	6
CONFERENCE ROOMS:	1
RECEPTION:	1
KITCHEN/ COPY ROOM:	1

ADJUSTED FOR SOCIAL DISTANCING

NOT TO SCALE

FURNITURE NOT INCLUDED

For more information, please contact:

310.255.7777

leasing@douglasemmett.com

**Douglas  
Emmett**