
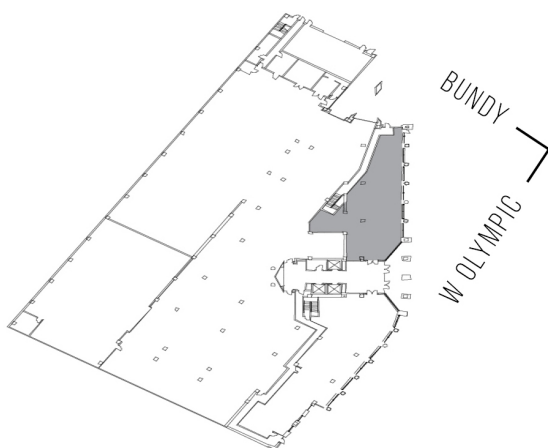


# 11900 OLYMPIC

BUNDY/OLYMPIC

SUITE 101 | 3,257 RSF

SAWTELLE/WEST LA

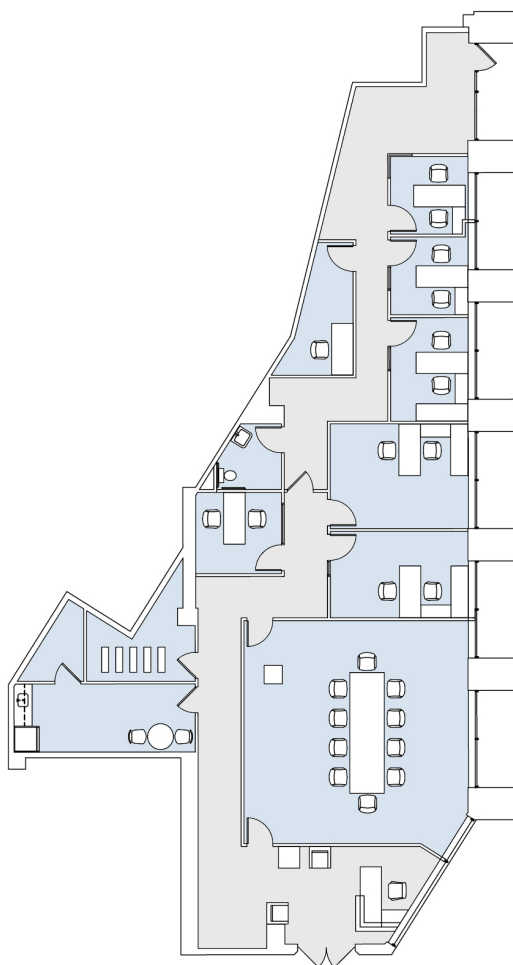

## AS-BUILT CONFIGURATION

OFFICES:	7
CONFERENCE ROOM:	1
RECEPTION:	1
KITCHEN:	1
I.T. ROOM:	1
STORAGE ROOM:	1
RESTROOM:	1

ADJUSTED FOR SOCIAL DISTANCING  
NOT TO SCALE  
FURNITURE NOT INCLUDED

For more information, please contact:

310.255.7777

[leasing@douglasemmett.com](mailto:leasing@douglasemmett.com)

**Douglas  
Emmett**