
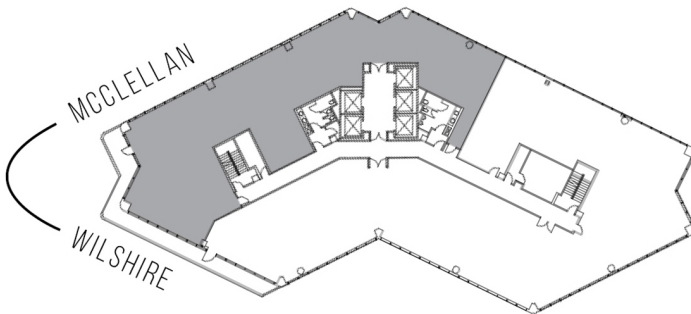


12400 WILSHIRE

SUITE 1400 | 5,714 RSF
BRENTWOOD-WILSHIRE

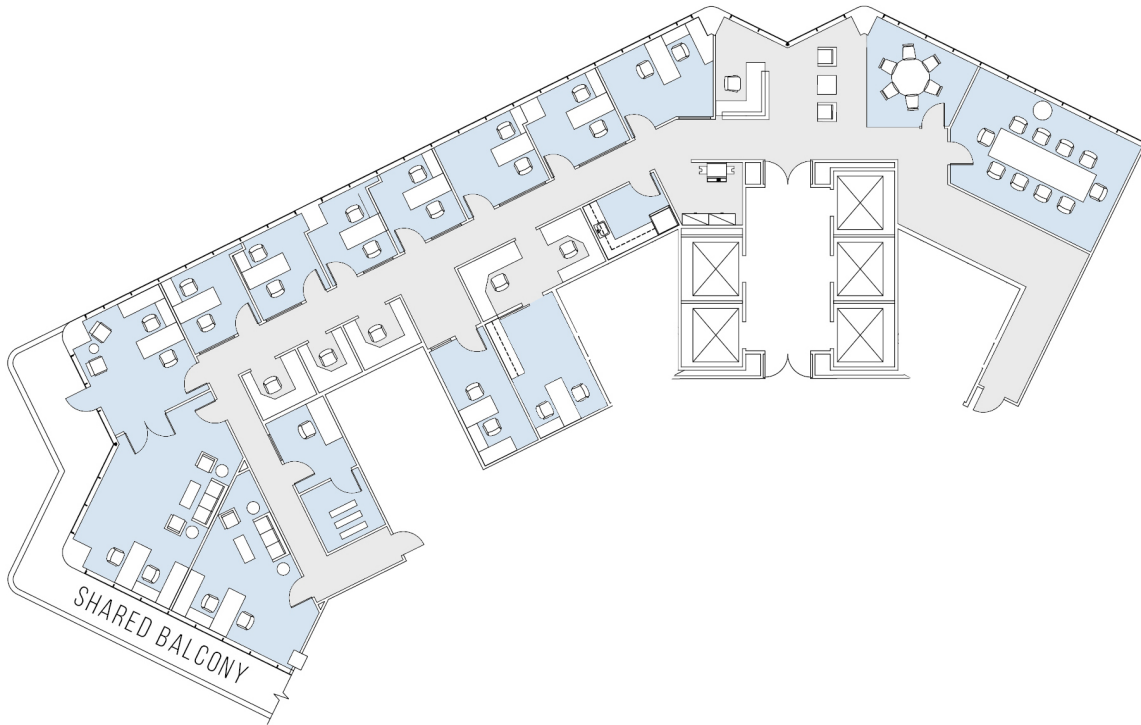

AS-BUILT CONFIGURATION

OFFICES:	13
CONFERENCE ROOMS:	2
RECEPTION:	1
KITCHEN:	1
I.T. ROOM:	1

ADJUSTED FOR SOCIAL DISTANCING

NOT TO SCALE

FURNITURE NOT INCLUDED

For more information, please contact:

310.255.7777

leasing@douglasemmett.com

**Douglas
Emmett**