

WOODLAND HILLS

CANOGA AVENUE

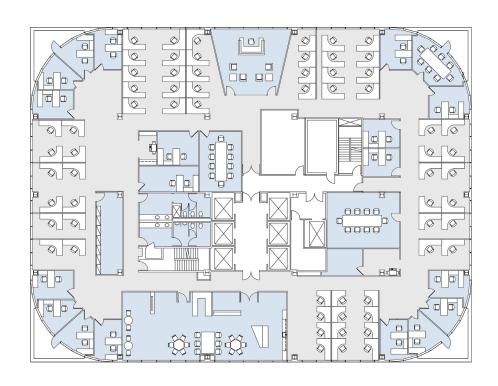

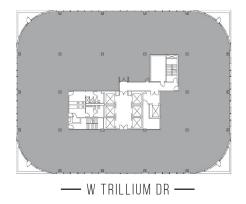

AS-BUILT CONFIGURATION

OFFICES:	18
CONFERENCE ROOMS:	3
RECEPTION:	1
BREAK ROOM:	1
FILE ROOM:	1
COPY ROOM:	1
STORAGE ROOM:	1
I.T. ROOM:	1
RESTROOMS:	1

ADJUSTED FOR SOCIAL DISTANCING NOT TO SCALE FURNITURE NOT INCLUDED

For more information, please contact:

310.255.7777 leasing@douglasemmett.com

