
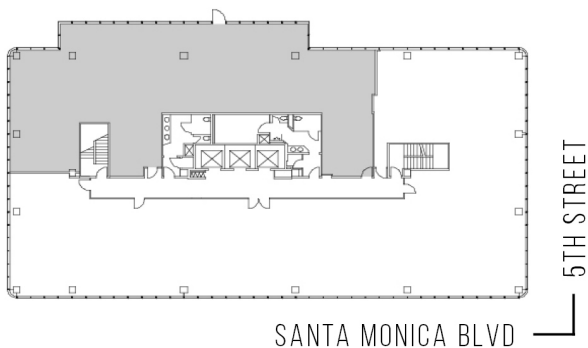


429

SANTA MONICA

SUITE 340 | 4,501 RSF

SANTA MONICA

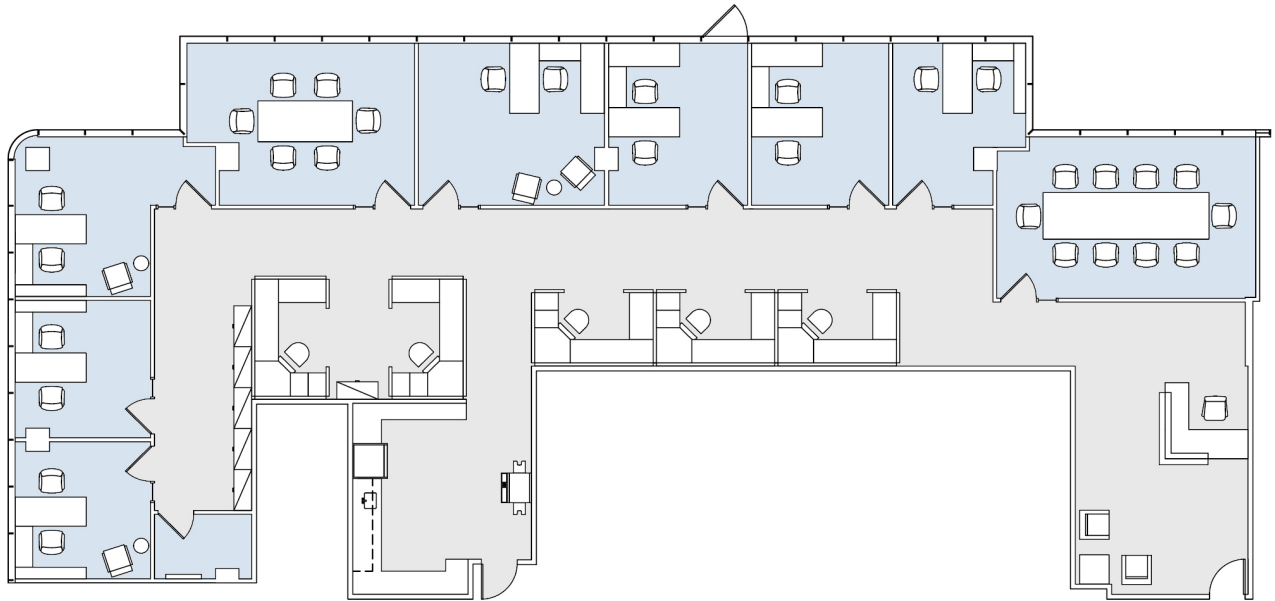

AS-BUILT CONFIGURATION

OFFICES:	7
CONFERENCE ROOMS:	2
RECEPTION:	1
KITCHEN:	1
I.T. CLOSET:	1

ADJUSTED FOR SOCIAL DISTANCING
NOT TO SCALE
FURNITURE NOT INCLUDED

For more information, please contact:

310.255.7777
leasing@douglasemmett.com

**Douglas
Emmett**