
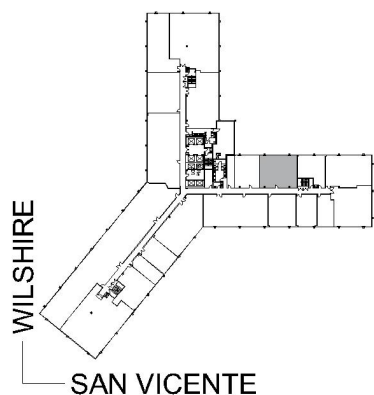


8383 WILSHIRE

SUITE 360 | 1,658 RSF
BEVERLY HILLS

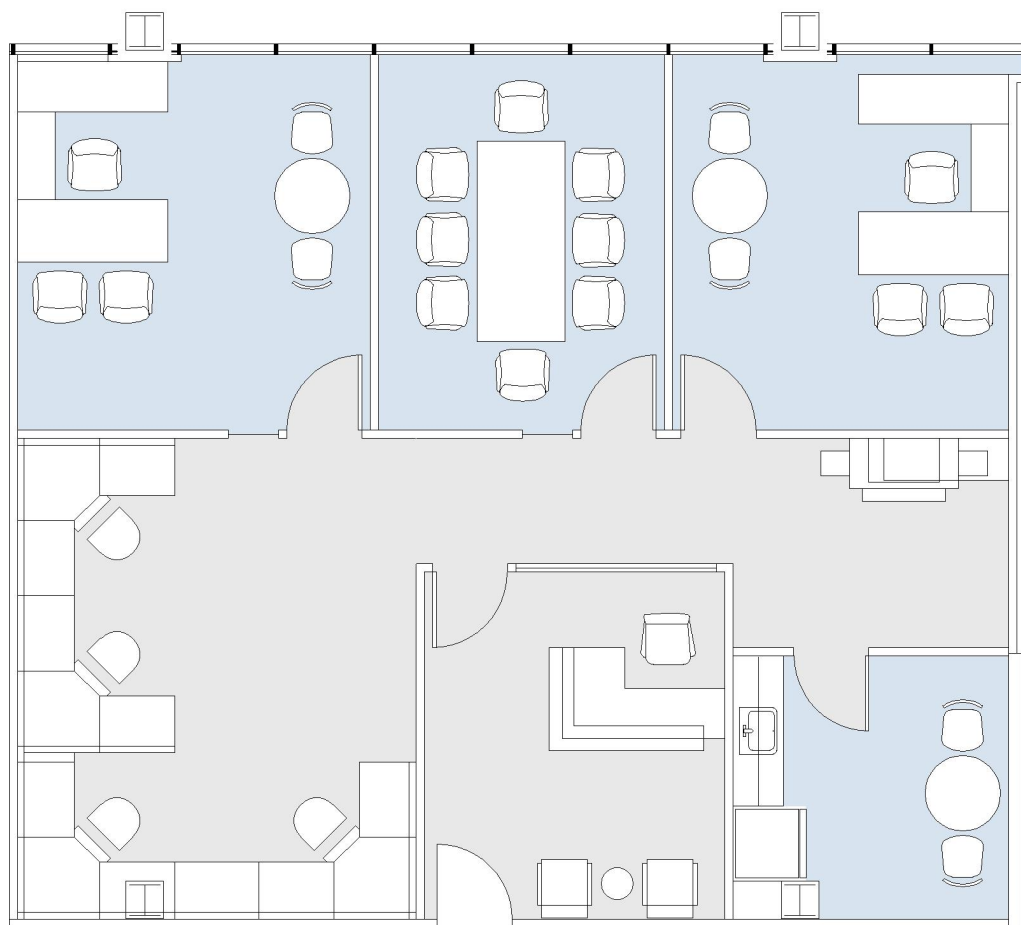

AS-BUILT CONFIGURATION

OFFICES:	2
CONFERENCE ROOM:	1
RECEPTION:	1
KITCHEN:	1

NOT TO SCALE

FURNITURE NOT INCLUDED

For more information, please contact:

310.255.7777
leasing@douglasemmett.com

**Douglas
Emmett**