
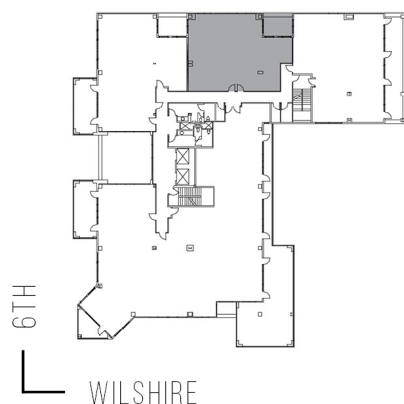


530 WILSHIRE

VERONA

SUITE 306 | 1,777 RSF

SANTA MONICA

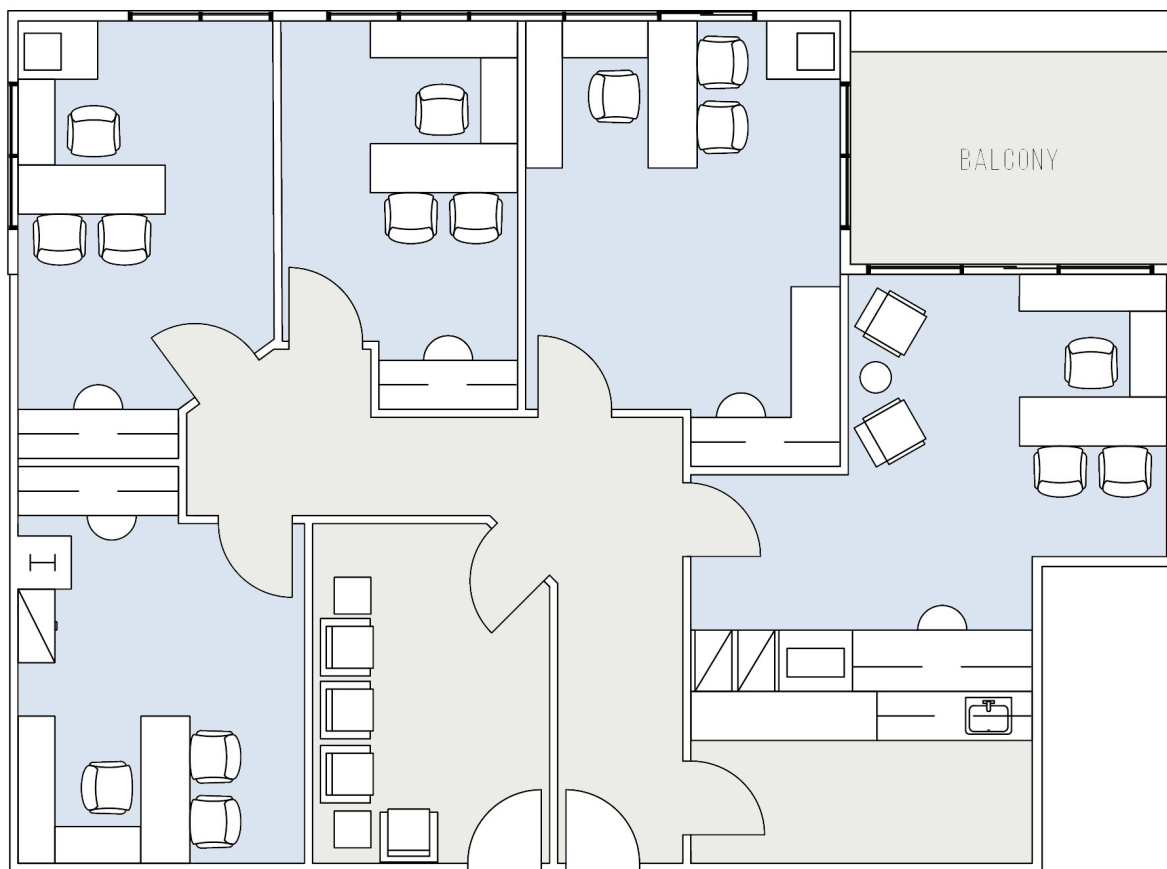

AS-BUILT CONFIGURATION

OFFICES:	5
RECEPTION:	1
KITCHEN:	1
WAITING AREA:	1
BALCONY:	1

NOT TO SCALE
FURNITURE NOT INCLUDED

For more information, please contact:

310.255.7777

leasing@douglasemmett.com

**Douglas
Emmett**