
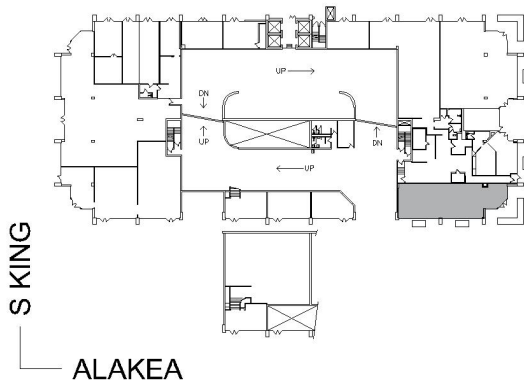


# 1001 BISHOP STREET

BISHOP SQUARE - ASB TOWER

SUITE 112 | 1,395 RSF

HONOLULU

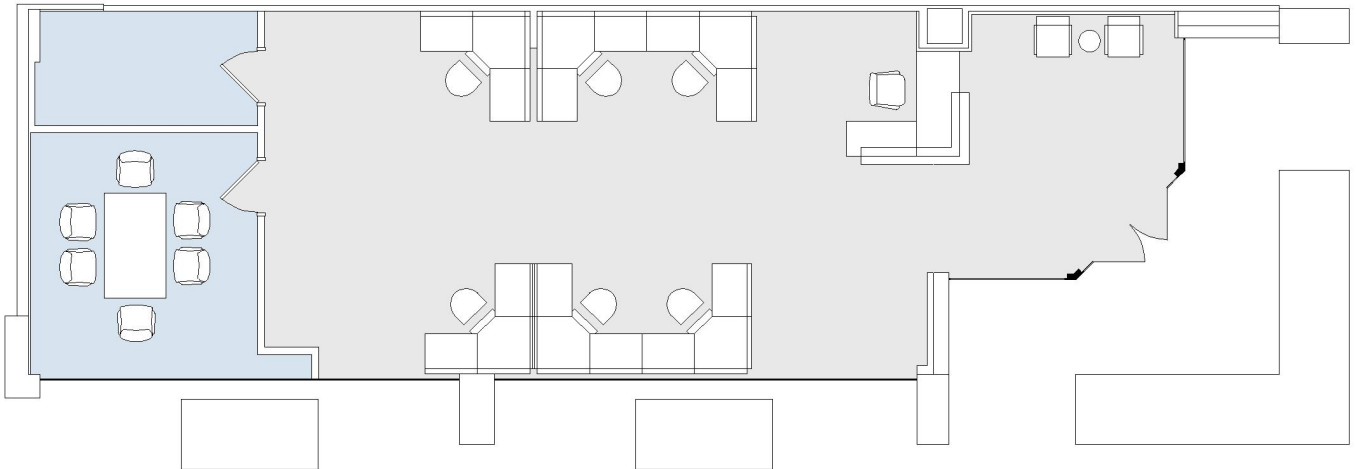

#### AS-BUILT CONFIGURATION

CONFERENCE ROOM:	1
RECEPTION:	1
STORAGE:	1

NOT TO SCALE  
FURNITURE NOT INCLUDED

For more information, please contact:

310.255.7777  
leasing@douglasemmett.com

**Douglas  
Emmett**