
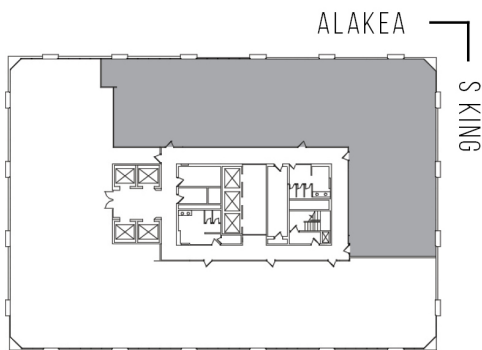


1001 BISHOP STREET

BISHOP SQUARE - ASB TOWER

SUITE 555 | 6,628 RSF

HONOLULU

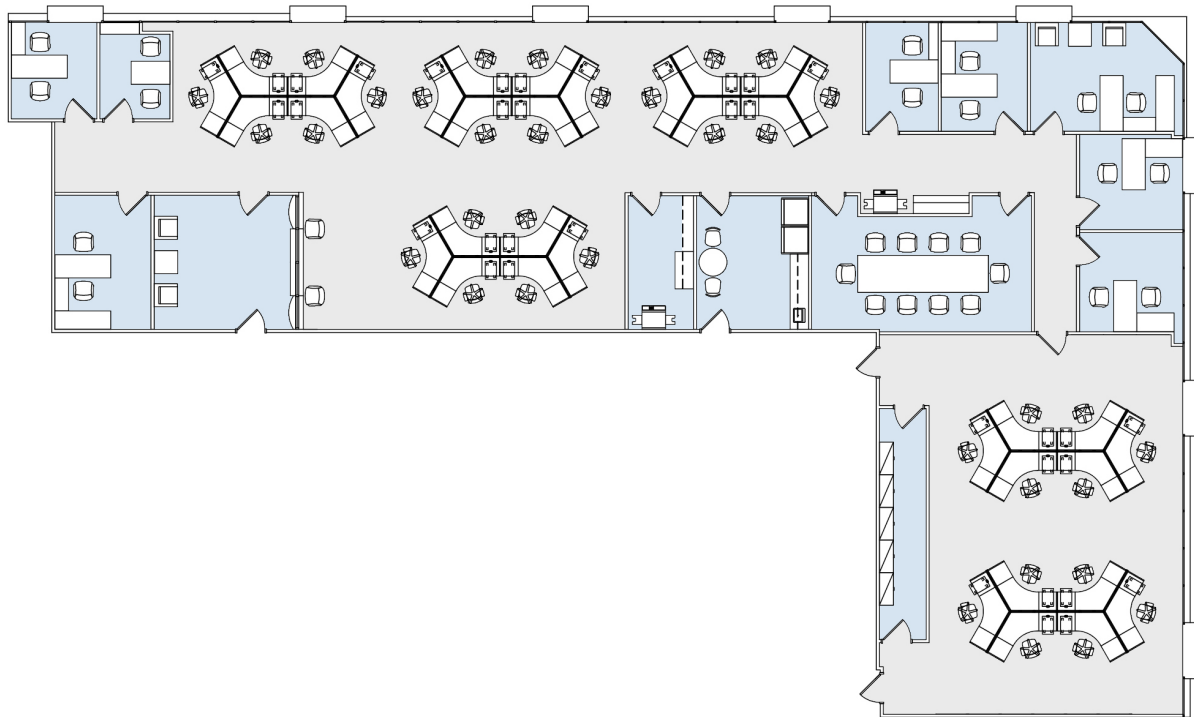

AS-BUILT CONFIGURATION

OFFICES:	8
CONFERENCE ROOM:	1
RECEPTION AREA:	1
BREAK ROOM:	1
OPEN WORK AREA:	2
FILE/ STORAGE ROOM:	1
COPY ROOM:	1

ADJUSTED FOR SOCIAL DISTANCING
NOT TO SCALE
FURNITURE NOT INCLUDED

For more information, please contact:

310.255.7777

leasing@douglasemmett.com

**Douglas
Emmett**