


# 1001 BISHOP STREET

BISHOP SQUARE - ASB TOWER

SUITE 630 | 592 RSF

HONOLULU

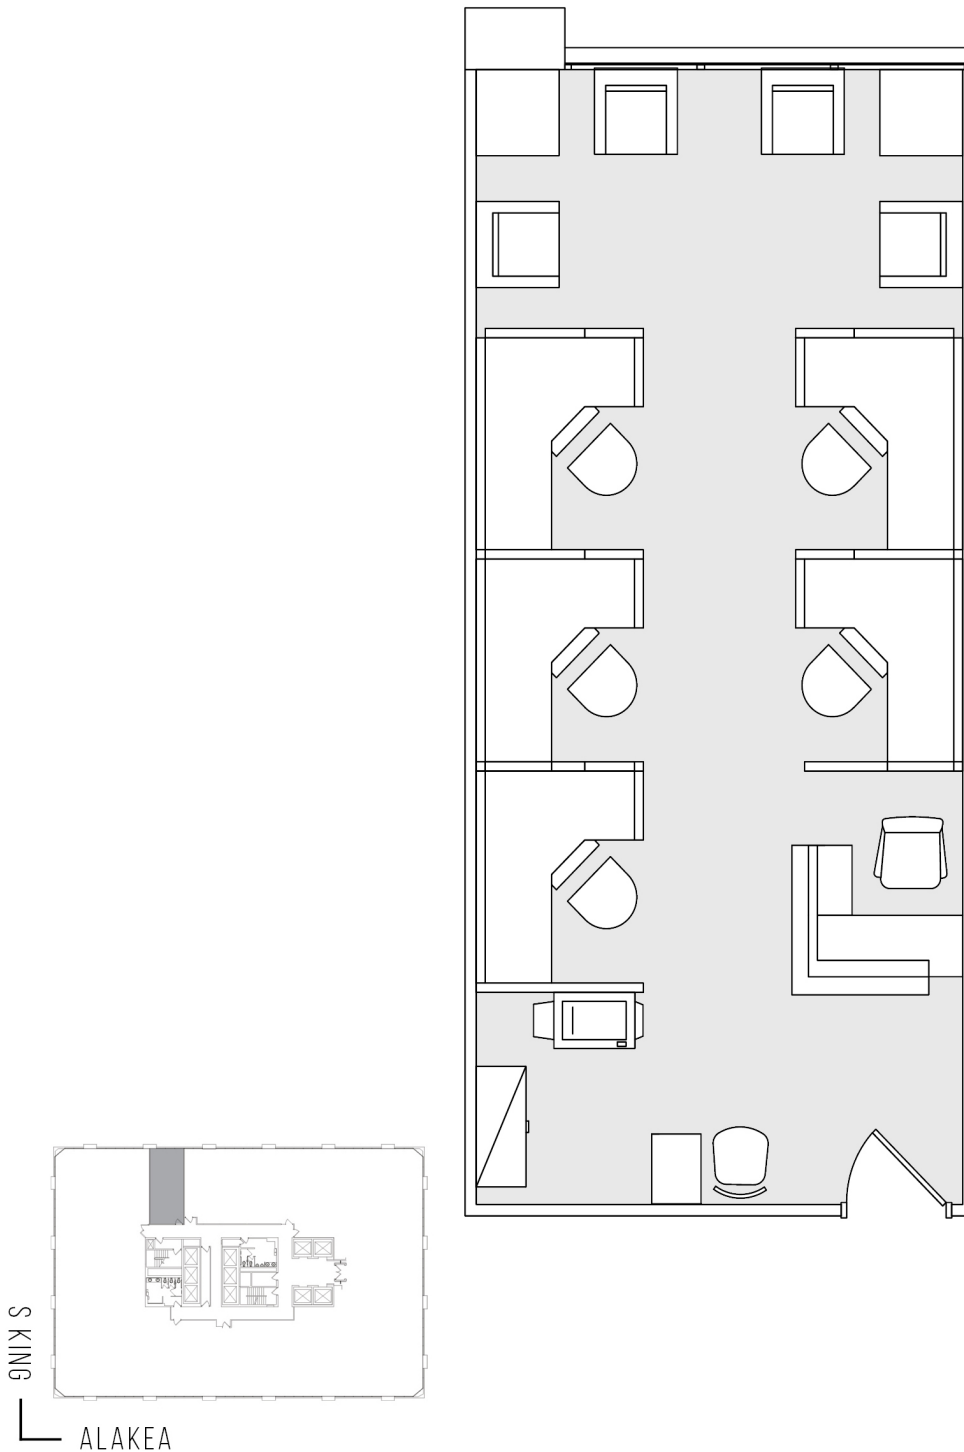

AS-BUILT CONFIGURATION

ADJUSTED FOR SOCIAL DISTANCING  
NOT TO SCALE  
FURNITURE NOT INCLUDED

For more information, please contact:

310.255.7777  
leasing@douglasemmett.com

**Douglas  
Emmett**