
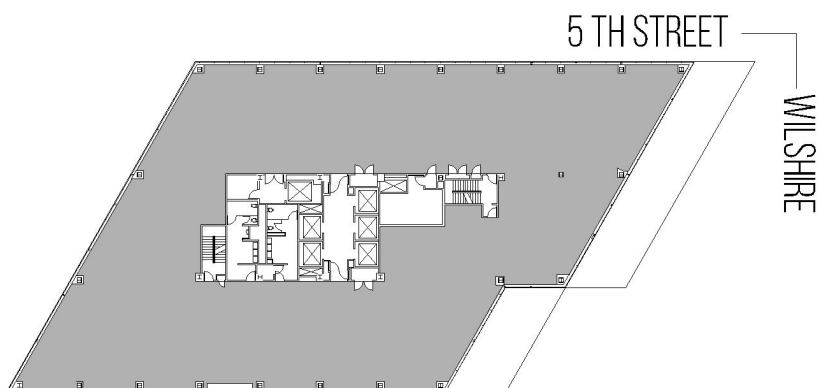


# 401 WILSHIRE

SUITE 400 | 17,872 RSF

SANTA MONICA

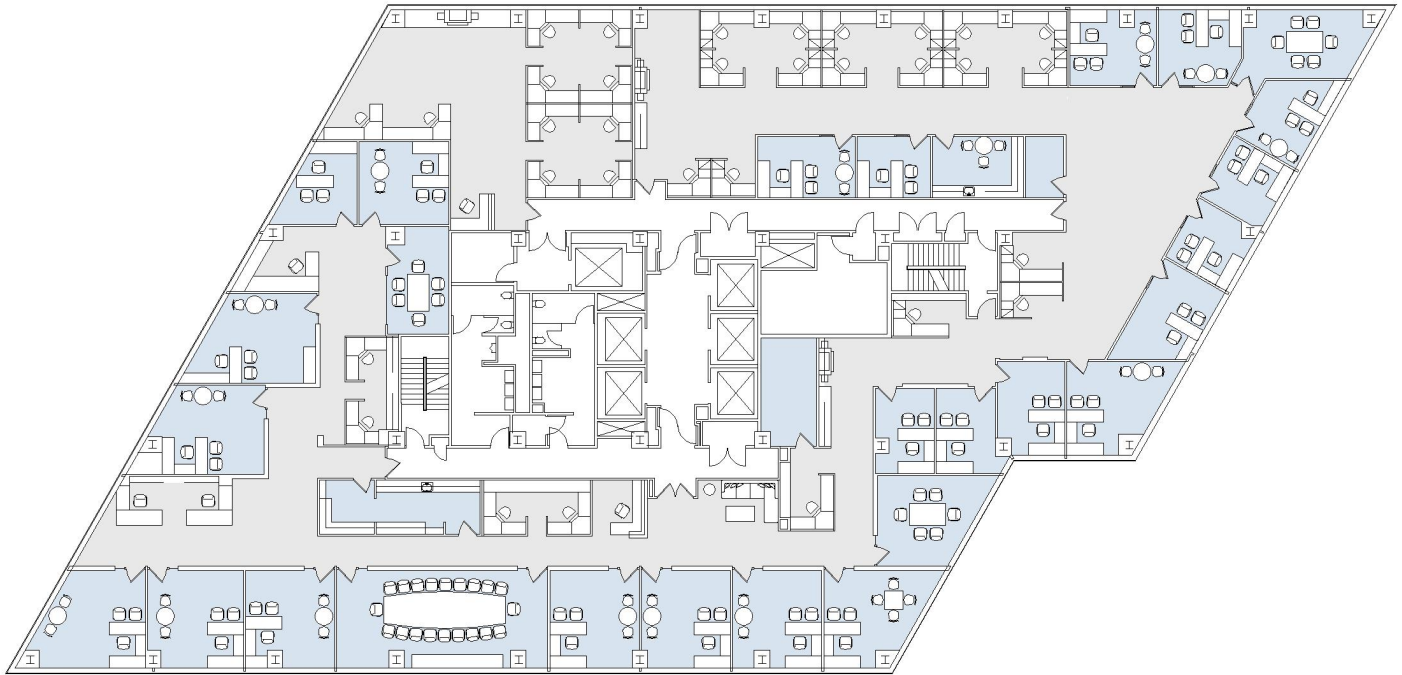

## AS-BUILT CONFIGURATION

OFFICES:	23
CONFERENCE ROOM:	4
RECEPTION:	1
KITCHEN:	2

NOT TO SCALE  
FURNITURE NOT INCLUDED

For more information, please contact:

310.255.7777  
leasing@douglasemmett.com

**Douglas  
Emmett**