


808 WILSHIRE

LINCOLN/WILSHIRE

SUITE 300 | 13,695 RSF

SANTA MONICA

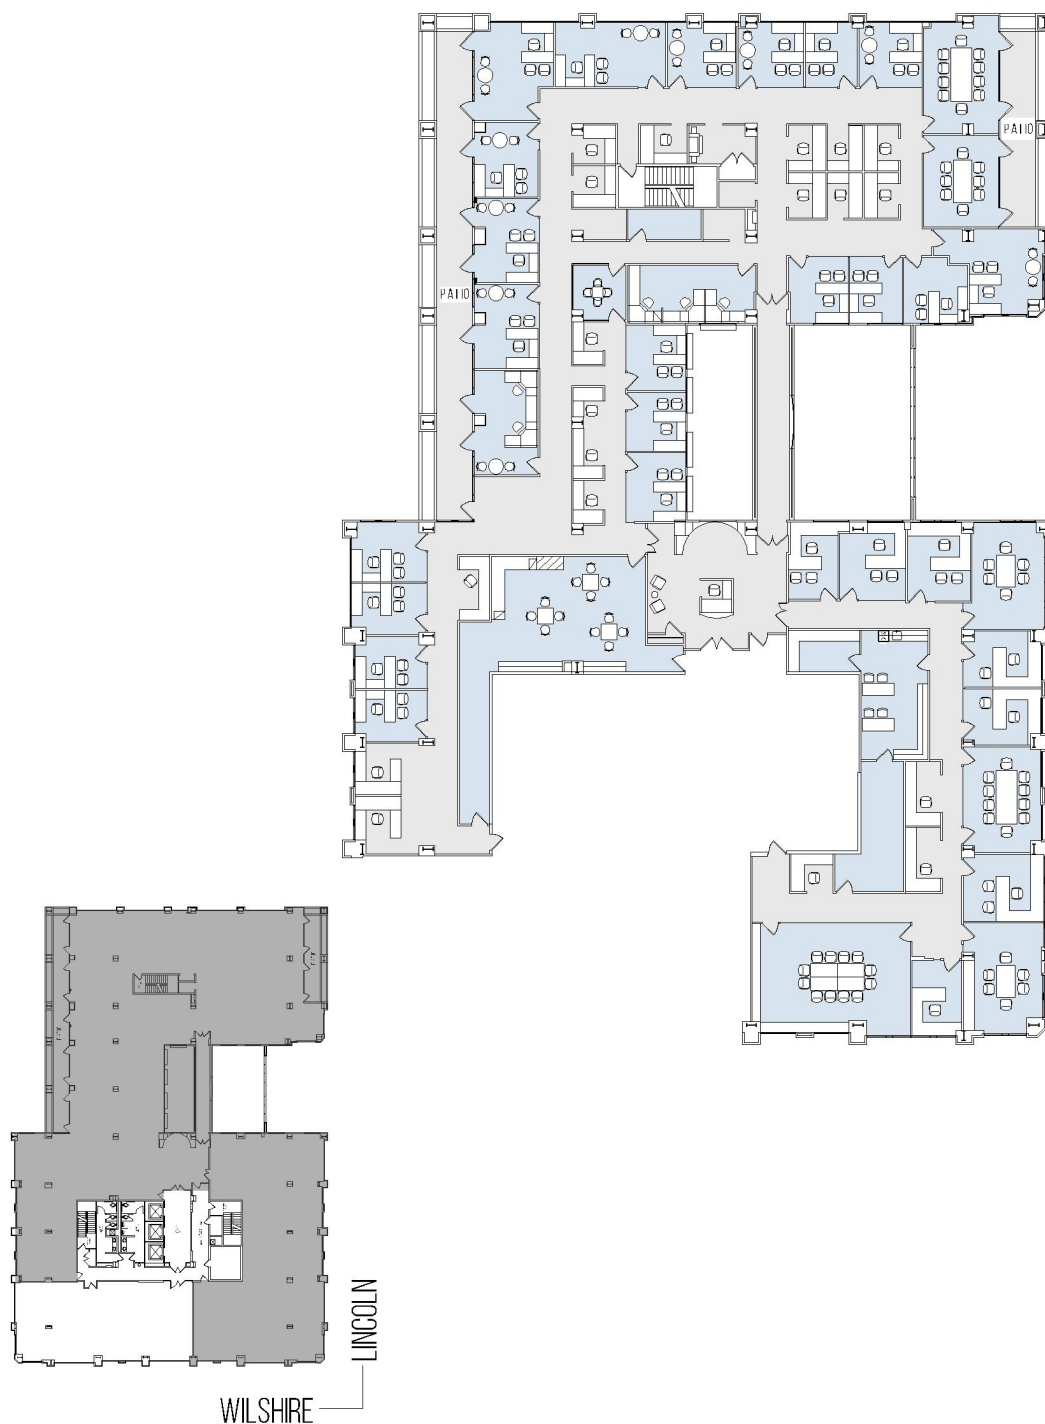

AS-BUILT CONFIGURATION

OFFICES:	27
CONFERENCE ROOM:	4
RECEPTION:	1
KITCHEN:	2
BREAK ROOM:	3
STORAGE ROOM:	2
IT ROOM:	1
PRIVATE PATIO:	2
SHARED OFFICE:	2

NOT TO SCALE
FURNITURE NOT INCLUDED

For more information, please contact:

310.255.7777

leasing@douglasemmett.com

**Douglas
Emmett**