
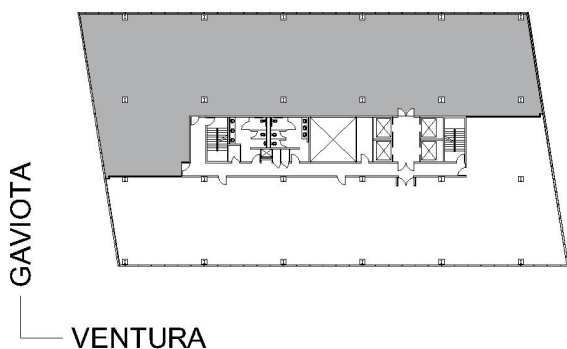


16000 VENTURA

SUITE 600 | 9,007 RSF
SHERMAN OAKS/ENCINO

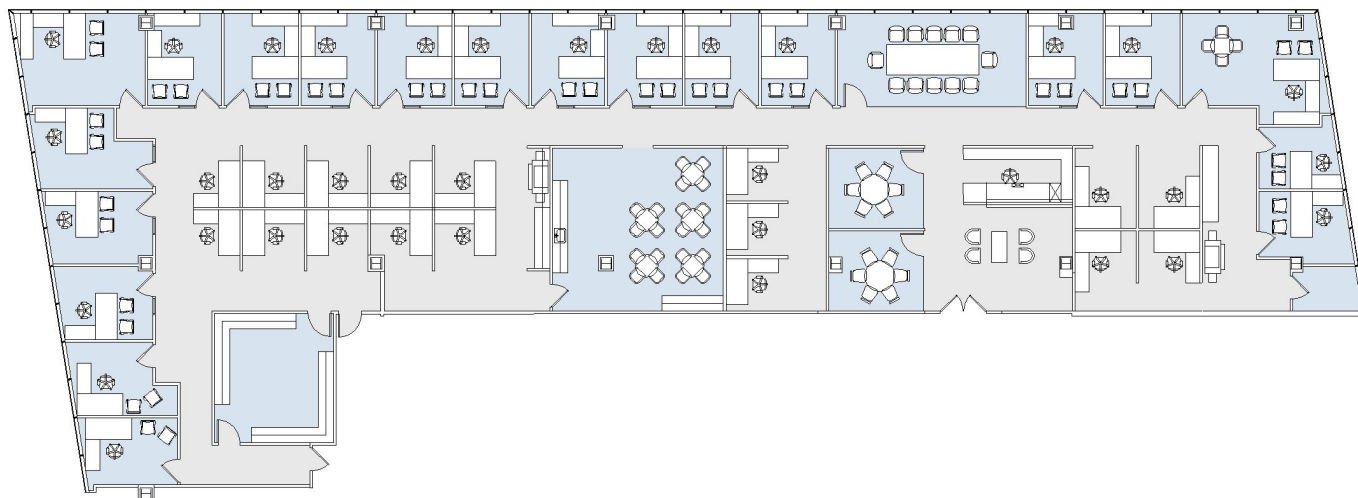

AS-BUILT CONFIGURATION

OFFICES:	20
CONFERENCE ROOM:	3
RECEPTION:	1
KITCHEN:	1
STORAGE:	2

NOT TO SCALE

FURNITURE NOT INCLUDED

For more information, please contact:

310.255.7777
leasing@douglasemmett.com

**Douglas
Emmett**