
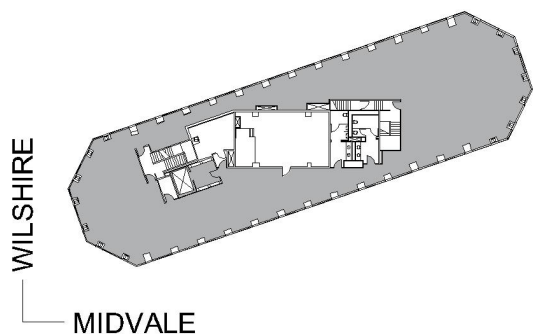


10940 WILSHIRE

THE TOWER

SUITE 2350 | 7,649 RSF

WESTWOOD

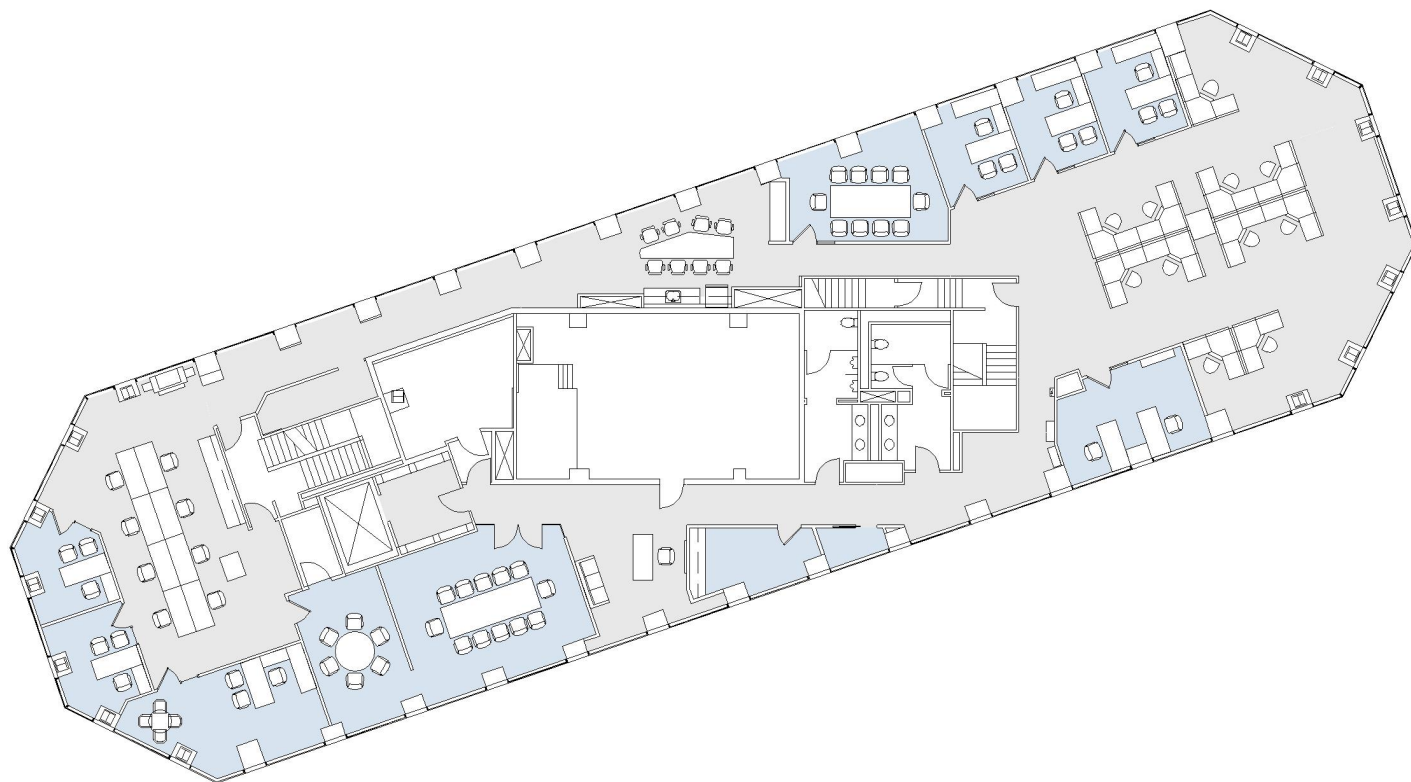

AS-BUILT CONFIGURATION

OFFICES:	7
CONFERENCE ROOM:	2
RECEPTION:	1
KITCHEN:	1
STORAGE ROOMS:	2

NOT TO SCALE

FURNITURE NOT INCLUDED

For more information, please contact:

310.255.7777

leasing@douglasemmett.com

**Douglas
Emmett**