
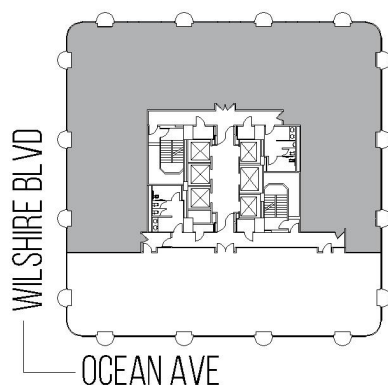


100 WILSHIRE

SUITE 1325 | 7,961 RSF

SANTA MONICA

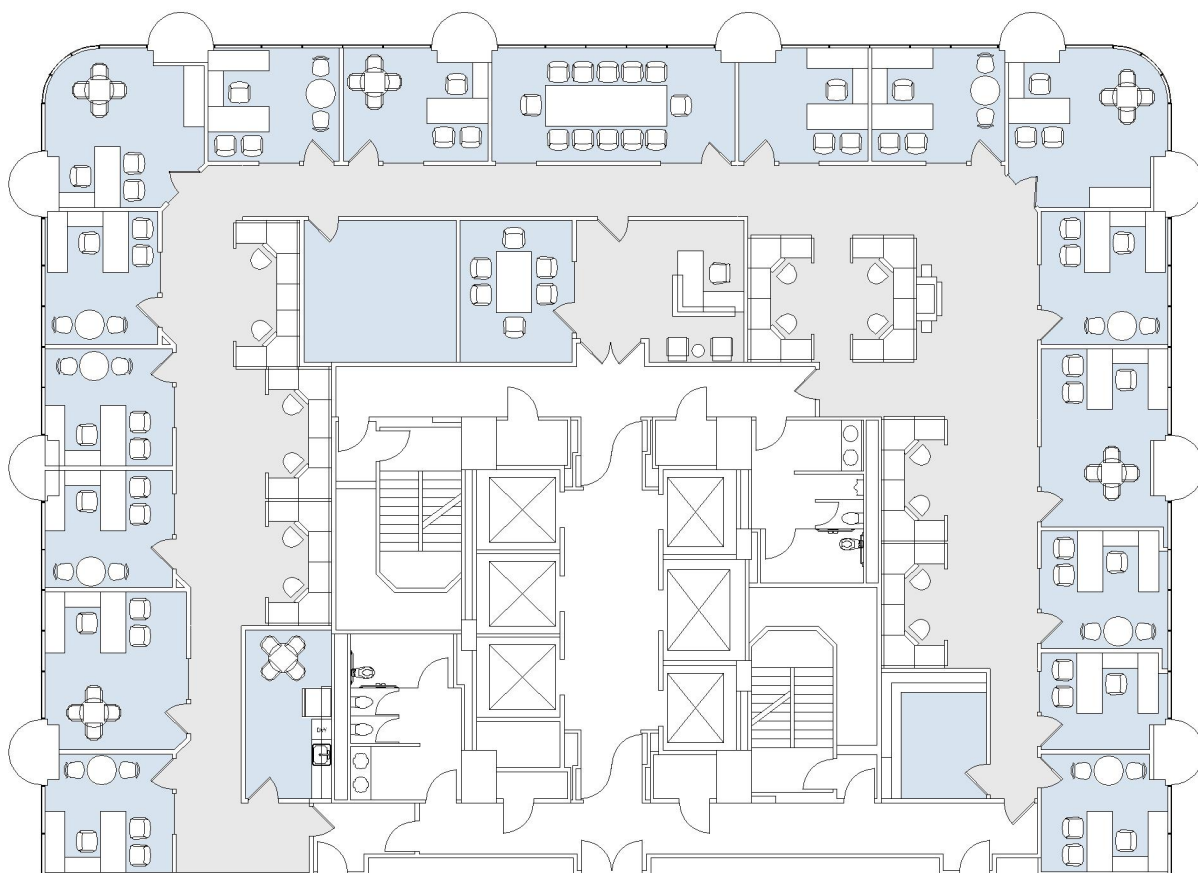

AS-BUILT CONFIGURATION

OFFICES:	16
CONFERENCE ROOM:	2
RECEPTION:	1
KITCHEN:	1
IT ROOM:	1
STORAGE ROOM:	1

NOT TO SCALE
FURNITURE NOT INCLUDED

For more information, please contact:

310.255.7777

leasing@douglasemmett.com

**Douglas
Emmett**