


1001 BISHOP STREET

BISHOP SQUARE - ASB TOWER

SUITE 2020 | 12,468 RSF

HONOLULU

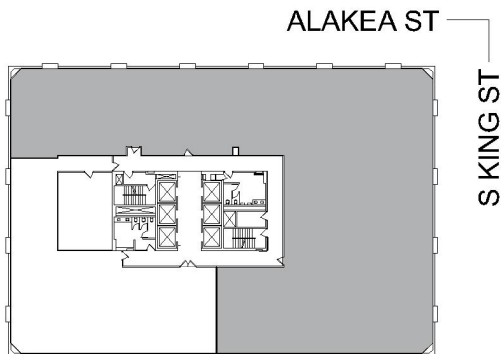

AS-BUILT CONFIGURATION

OFFICES:	32
CONFERENCE ROOM:	1
TRAINING ROOM:	2
RECEPTION:	1
KITCHEN:	1
STORAGE ROOM:	2

NOT TO SCALE

FURNITURE NOT INCLUDED

For more information, please contact:

310.255.7777

leasing@douglasemmett.com

**Douglas
Emmett**