


12121 WILSHIRE

WILSHIRE BUNDY PLAZA

SUITE 710 | 2,888 RSF
BRENTWOOD-WILSHIRE

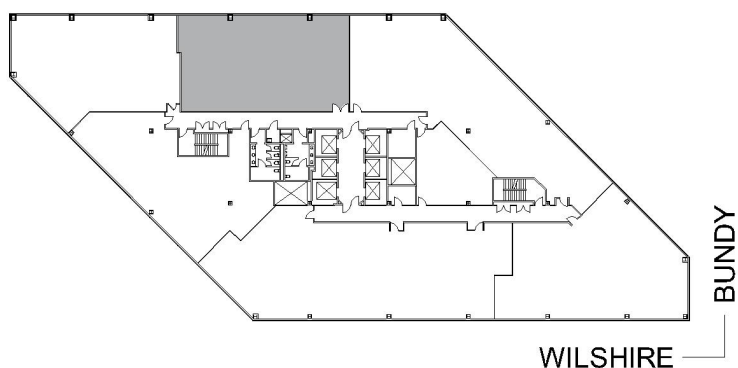

AS-BUILT CONFIGURATION

OFFICES:	5
CONFERENCE ROOM:	1
RECEPTION:	1
KITCHEN:	1
IT / COPY ROOM:	1

NOT TO SCALE

FURNITURE NOT INCLUDED

For more information, please contact:

310.255.7777

leasing@douglasemmett.com

**Douglas
Emmett**