
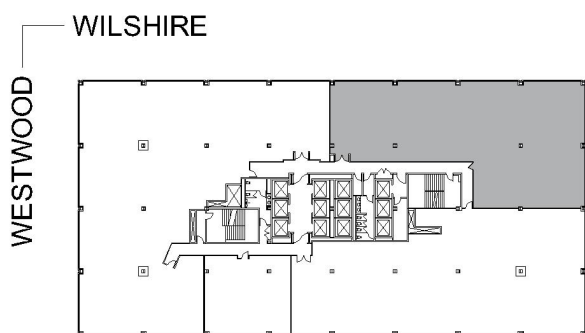


10880 WILSHIRE

SUITE 1420 | 6,366 RSF
WESTWOOD

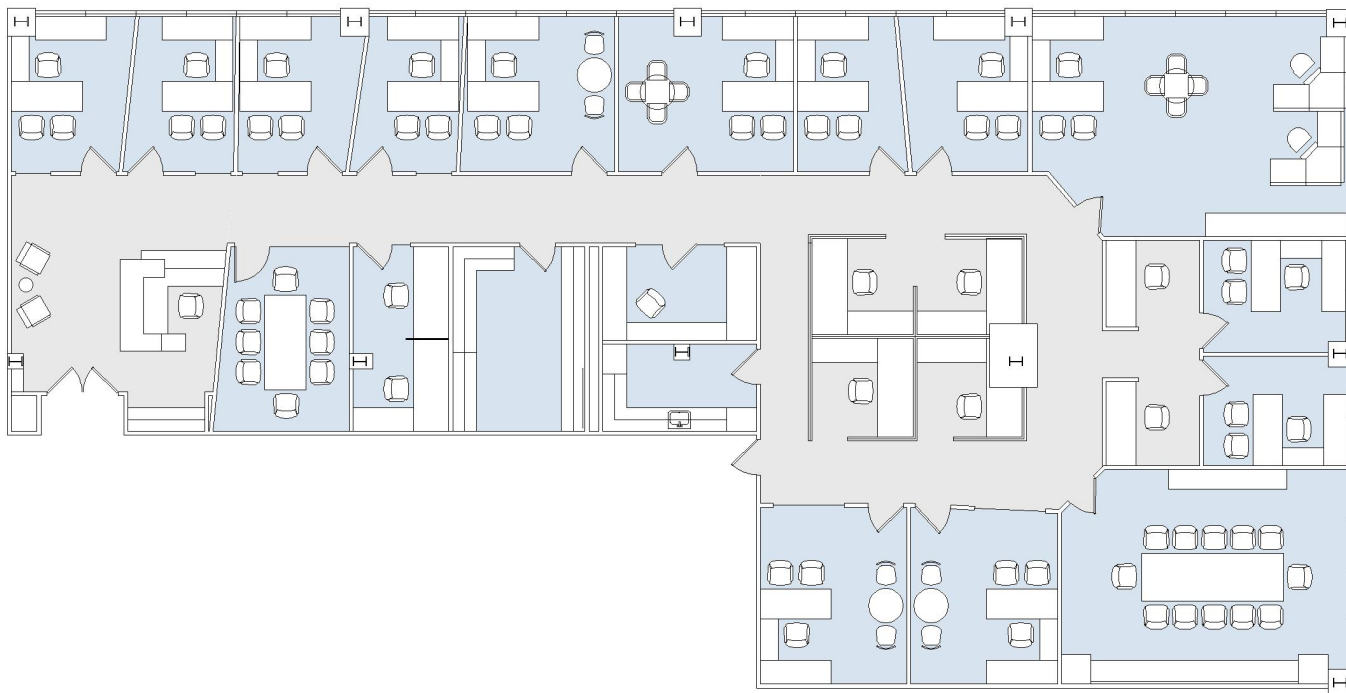

AS-BUILT CONFIGURATION

OFFICES:	15
CONFERENCE ROOM:	2
RECEPTION:	1
KITCHEN:	1
FILE / COPY ROOM:	1

NOT TO SCALE

FURNITURE NOT INCLUDED

For more information, please contact:

310.255.7777

leasing@douglasemmett.com

**Douglas
Emmett**