



6310

CARTHAY CAMPUS 10

SUITE 275 | 7,503 RSF

BEVERLY HILLS

SAN VICENTE

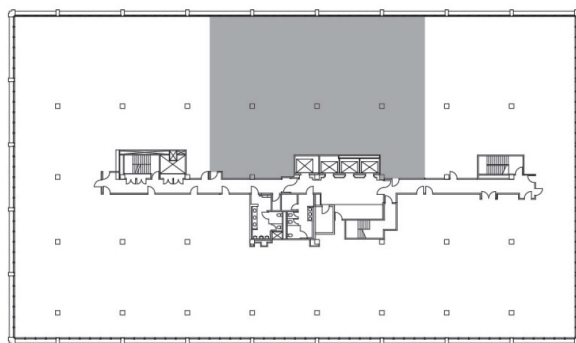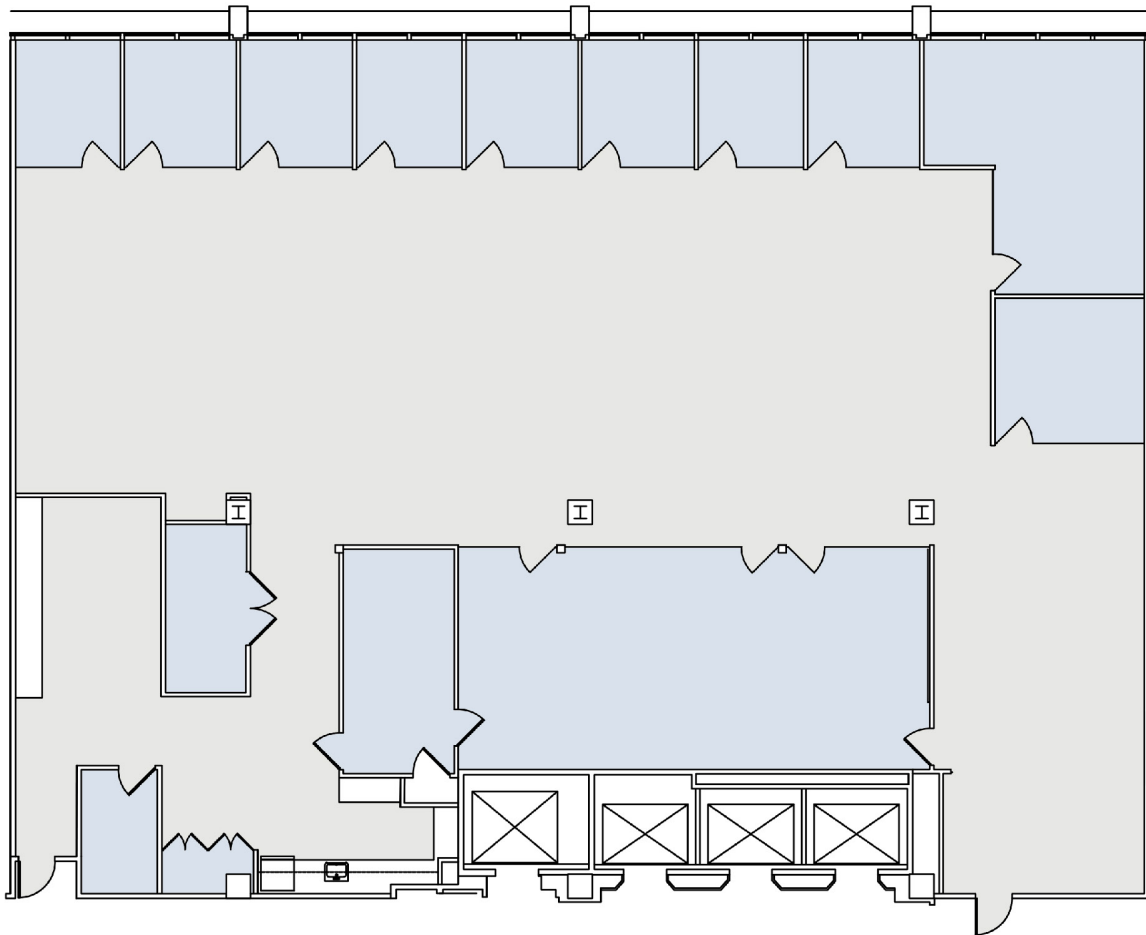

CARRILLO

SAN VICENTE

AS-BUILT CONFIGURATION

OFFICES:	10
CONFERENCE:	2
RECEPTION AREA:	1
KITCHEN:	1
IT ROOM:	1
STORAGE:	1

NOT TO SCALE
FURNITURE NOT INCLUDED

For more information, please contact:

310.255.7777

leasing@douglasemmett.com

**Douglas
Emmett**