
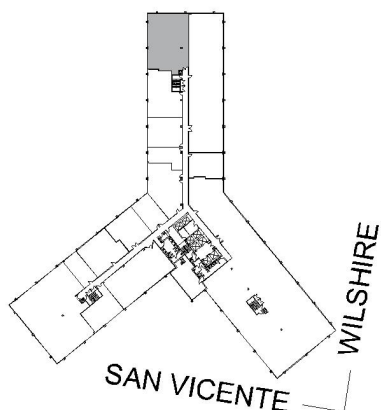


# 8383 WILSHIRE

SUITE 420 | 2,873 RSF  
BEVERLY HILLS

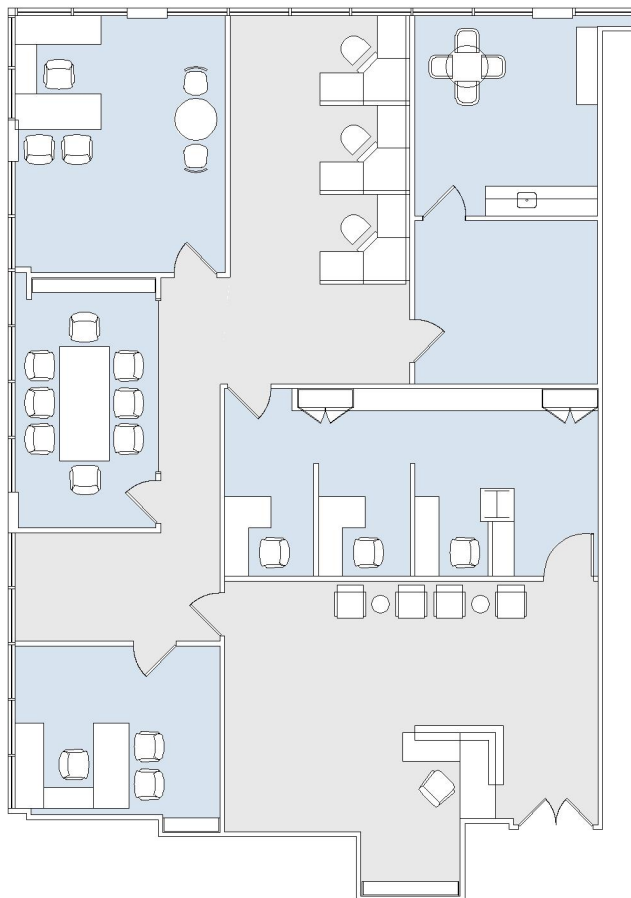

#### AS-BUILT CONFIGURATION

OFFICES:	2
SHARE OFFICE:	1
CONFERENCE ROOM:	1
RECEPTION:	1
KITCHEN:	1
STORAGE:	1

NOT TO SCALE  
FURNITURE NOT INCLUDED

For more information, please contact:

310.255.7777  
leasing@douglasemmett.com

**Douglas  
Emmett**