



6310

CARTHAY CAMPUS 10

SUITE 100 | 8,968 RSF

BEVERLY HILLS

SAN VICENTE

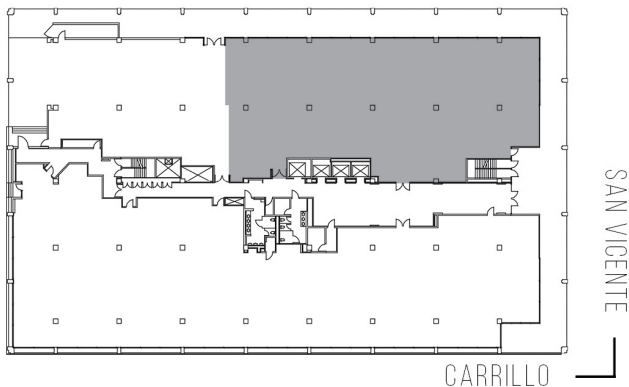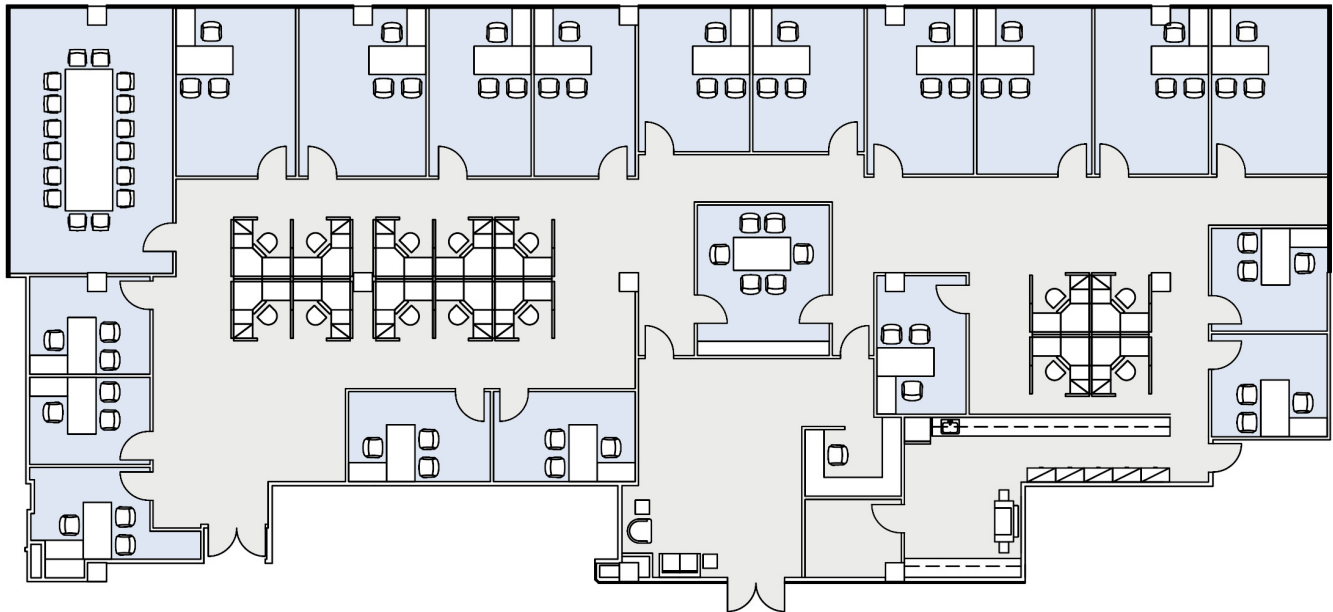

AS-BUILT CONFIGURATION

OFFICES:	18
CONFERENCE:	2
RECEPTION:	1
KITCHEN/COPY ROOM:	1
IT ROOM:	1

NOT TO SCALE
FURNITURE NOT INCLUDED

For more information, please contact:

310.255.7777

leasing@douglasemmett.com

**Douglas
Emmett**