
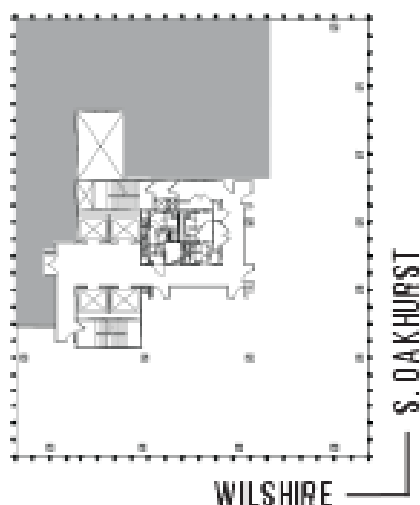


9100 WILSHIRE

9100 WILSHIRE WEST TOWER

SUITE W0950 | 4,073 RSF

BEVERLY HILLS

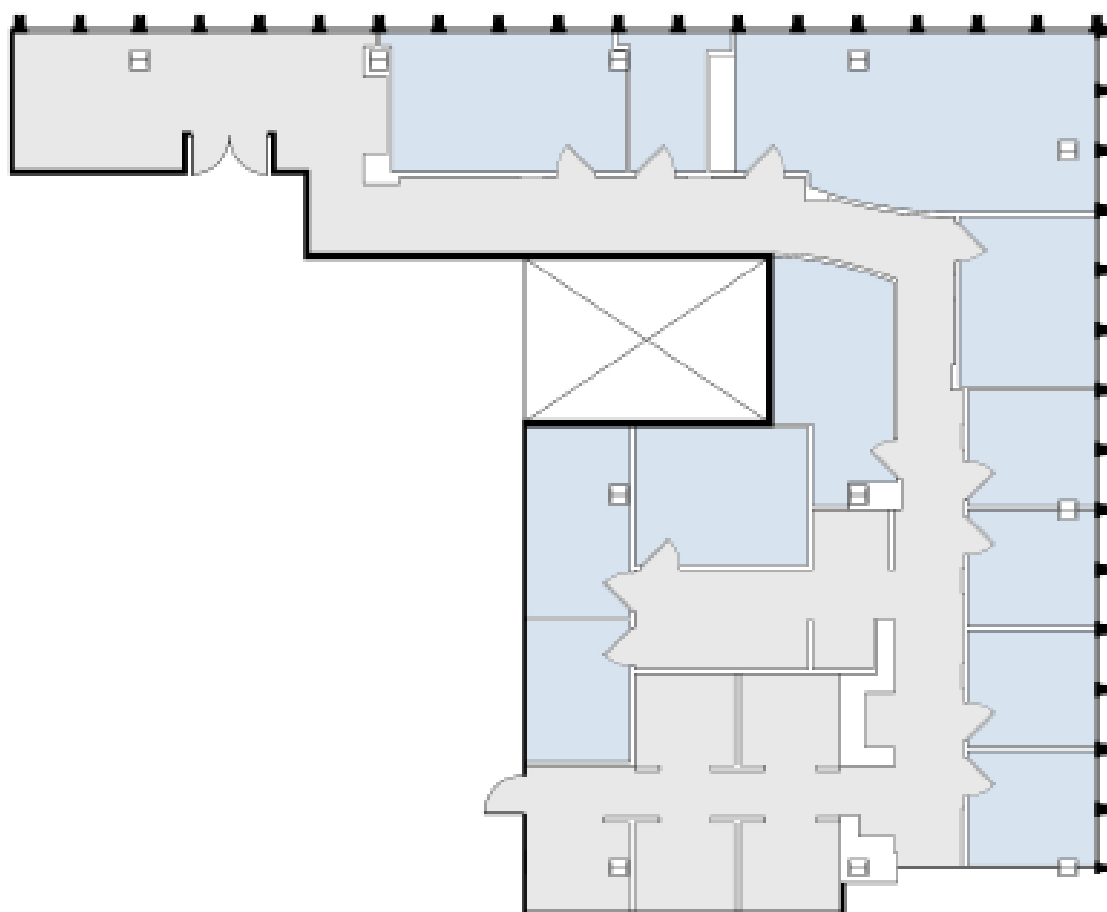

AS-BUILT CONFIGURATION

WINDOW OFFICES:	6
INTERIOR OFFICES	4
EXECUTIVE OFFICE	1
CONFERENCE ROOM:	1
RECEPTION:	1
KITCHEN:	1

For more information, please contact:

310.255.7777

leasing@douglasemmett.com

**Douglas
Emmett**