
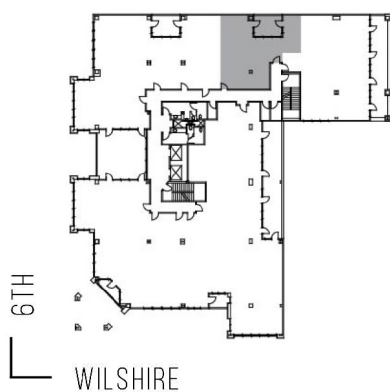


# 530 WILSHIRE

VERONA

SUITE 206 | 1,160 RSF

SANTA MONICA

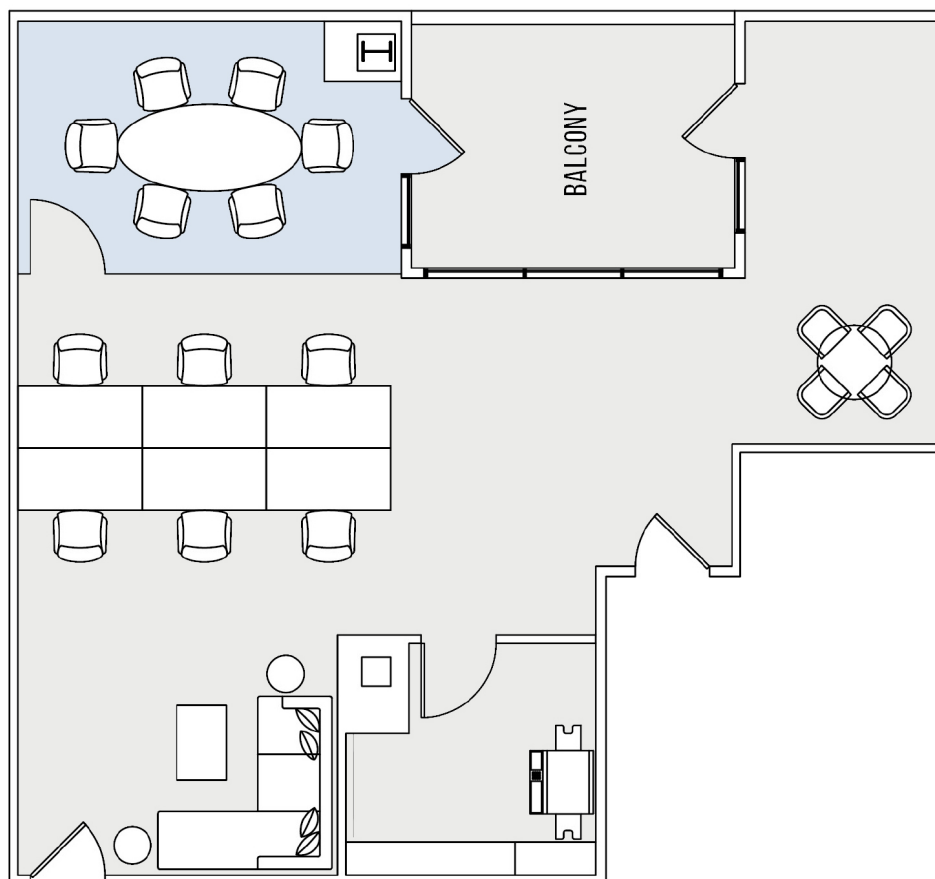

## AS-BUILT CONFIGURATION

RECEPTION:	1
CONFERENCE ROOM:	1
BALCONY:	1
COPY/UTILITY ROOM:	1

NOT TO SCALE  
FURNITURE NOT INCLUDED

For more information, please contact:

310.255.7777

leasing@douglasemmett.com

**Douglas  
Emmett**