
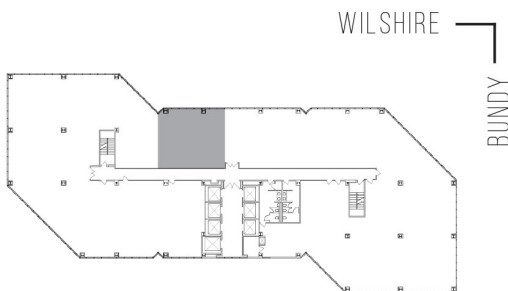


# 12100 WILSHIRE

SUITE 1550 | 1,377 RSF

BRENTWOOD-WILSHIRE

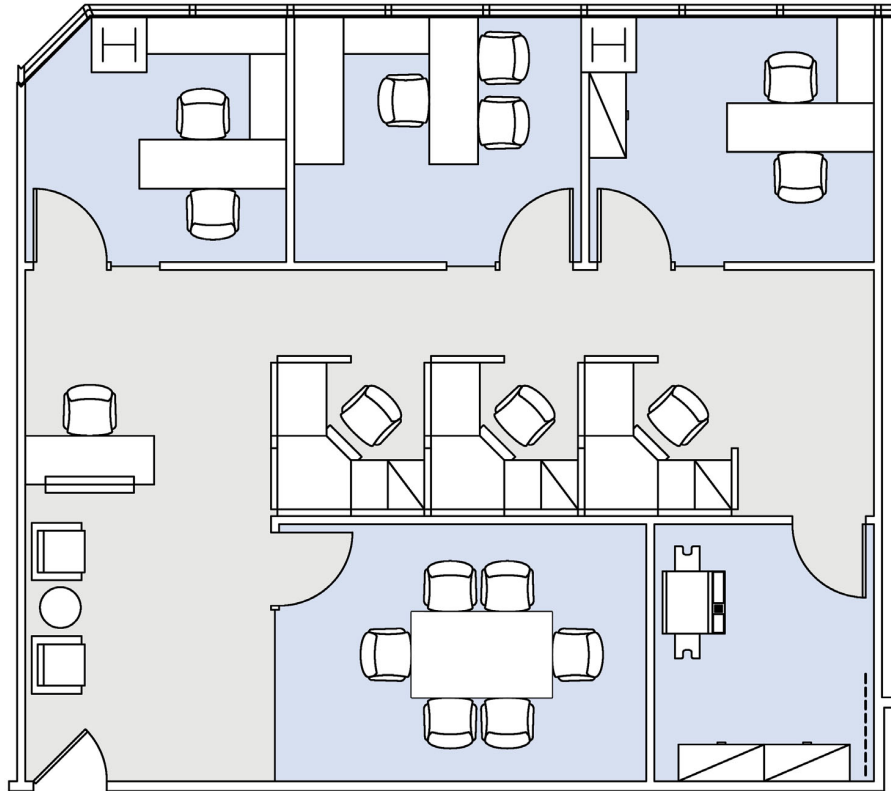

## AS-BUILT CONFIGURATION

OFFICES:	3
WORKSTATIONS:	3
RECEPTION:	1
CONFERENCE ROOM:	1
COPY ROOM:	1

NOT TO SCALE  
FURNITURE NOT INCLUDED

For more information, please contact:

310.255.7777

[leasing@douglasemmett.com](mailto:leasing@douglasemmett.com)

**Douglas  
Emmett**