
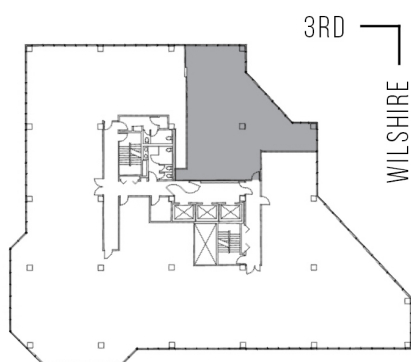


233 WILSHIRE

SUITE 340 | 2,018 RSF

SANTA MONICA

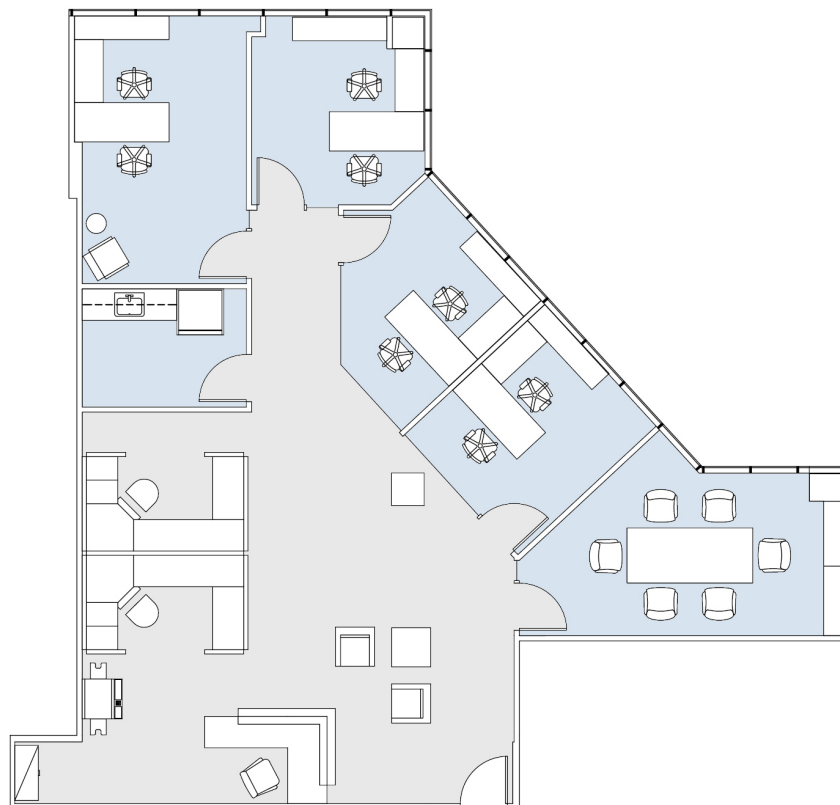

AS-BUILT CONFIGURATION

OFFICES:	4
CONFERENCE ROOM:	1
RECEPTION:	1
KITCHEN:	1

ADJUSTED FOR SOCIAL DISTANCING

NOT TO SCALE

FURNITURE NOT INCLUDED

For more information, please contact:

310.255.7777

leasing@douglasemmett.com

**Douglas
Emmett**