
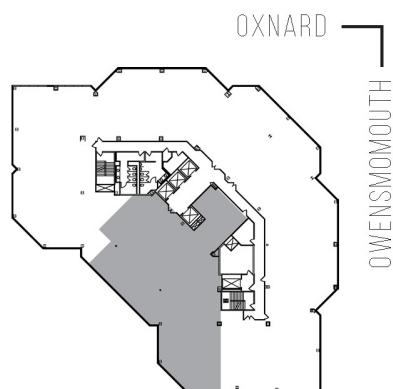


21700 OXNARD STREET

WARNER CENTER TOWER - VI

SUITE 1700 | 7,137 RSF

WOODLAND HILLS

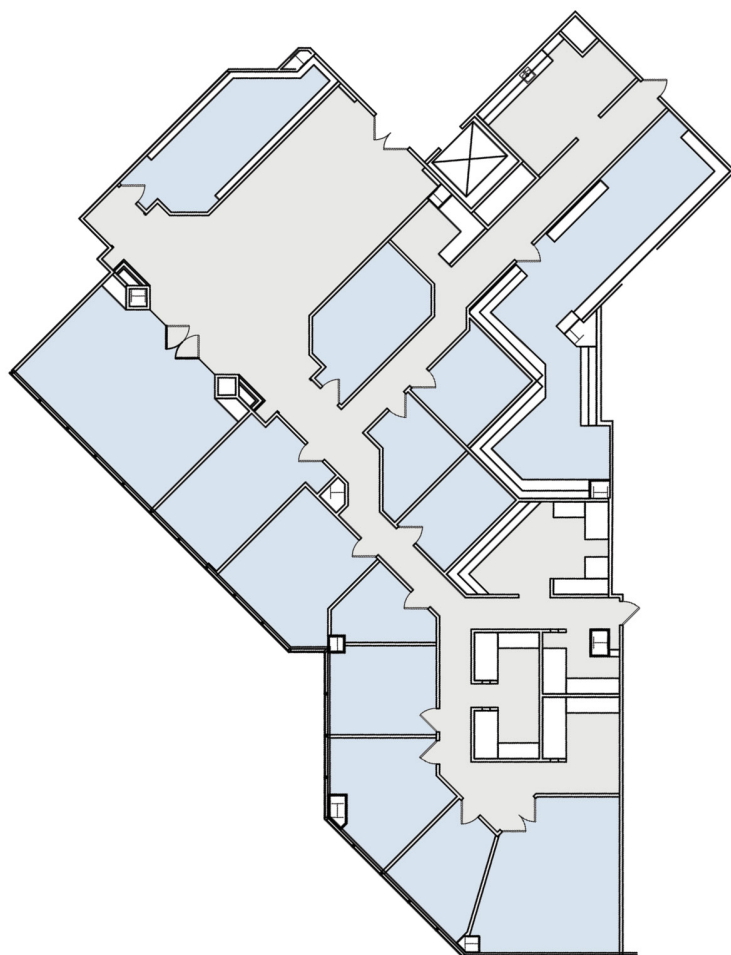

AS-BUILT CONFIGURATION

OFFICES:	9
CONFERENCE ROOM:	2
RECEPTION:	1
COPY/FILE ROOM:	2
KITCHEN:	1

NOT TO SCALE
FURNITURE NOT INCLUDED

For more information, please contact:

310.255.7777

leasing@douglasemmett.com

**Douglas
Emmett**