
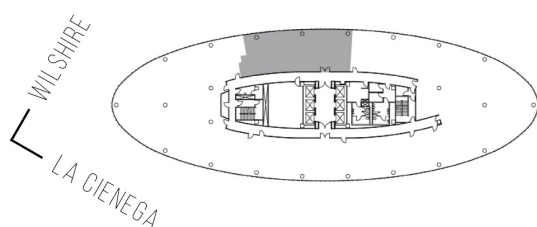


8484 WILSHIRE

SUITE 500 | 2,463 RSF
BEVERLY HILLS

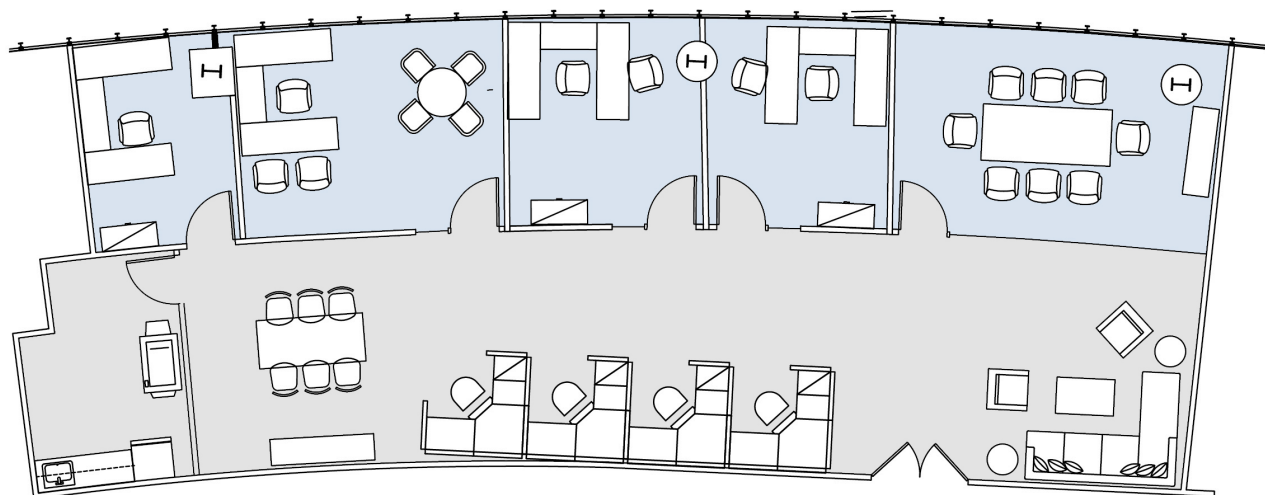

AS-BUILT CONFIGURATION

| | |
|------------------|---|
| OFFICES: | 4 |
| CONFERENCE ROOM: | 1 |
| RECEPTION: | 1 |
| KITCHEN: | 1 |

NOT TO SCALE
FURNITURE NOT INCLUDED

For more information, please contact:

310.255.7777
leasing@douglasemmett.com

**Douglas
Emmett**