
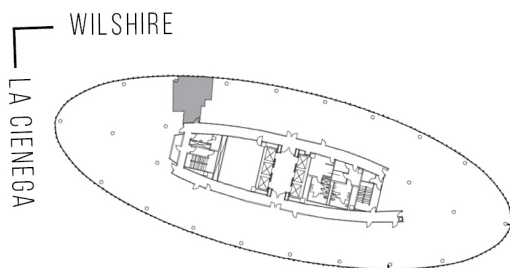


8484 WILSHIRE

SUITE 502 | 635 RSF
BEVERLY HILLS

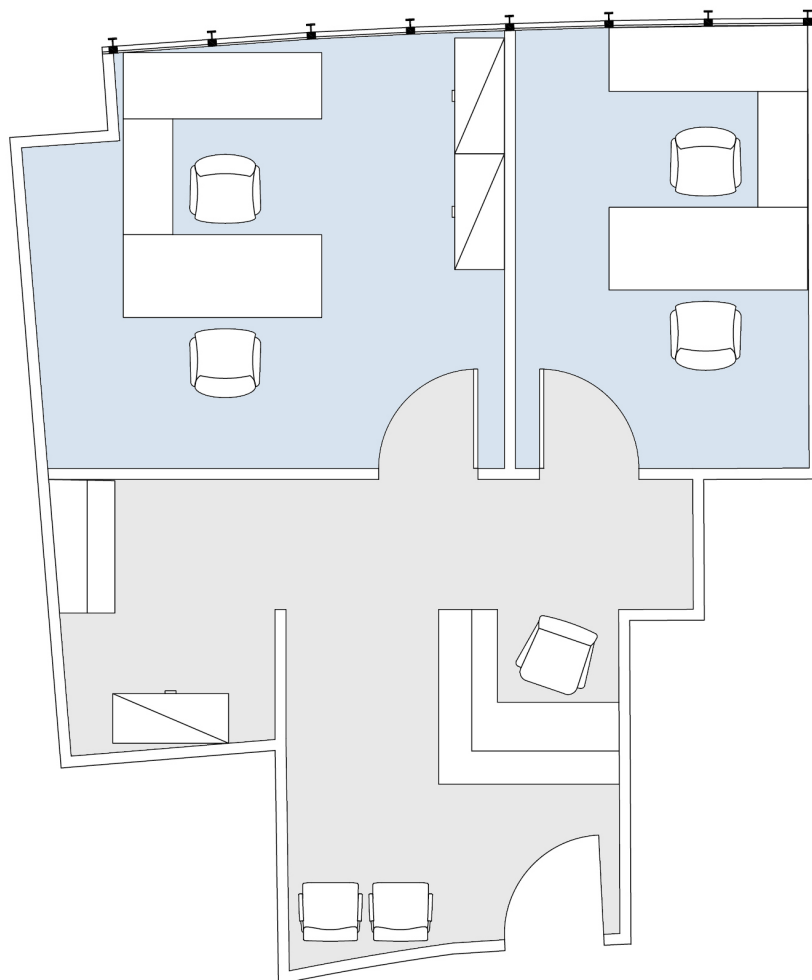

AS-BUILT CONFIGURATION	
OFFICES:	2
RECEPTION:	1
ADJUSTED FOR SOCIAL DISTANCING	
NOT TO SCALE	
FURNITURE NOT INCLUDED	

For more information, please contact:

310.255.7777

leasing@douglasemmett.com

**Douglas
Emmett**