
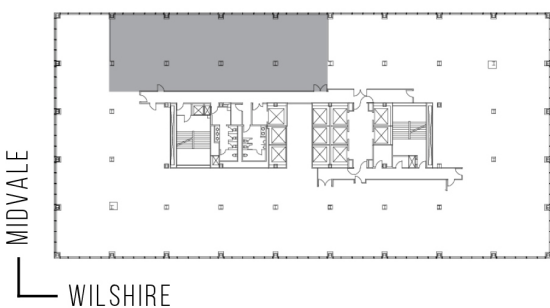


10960 WILSHIRE

SUITE 1260 | 4,330 RSF
WESTWOOD

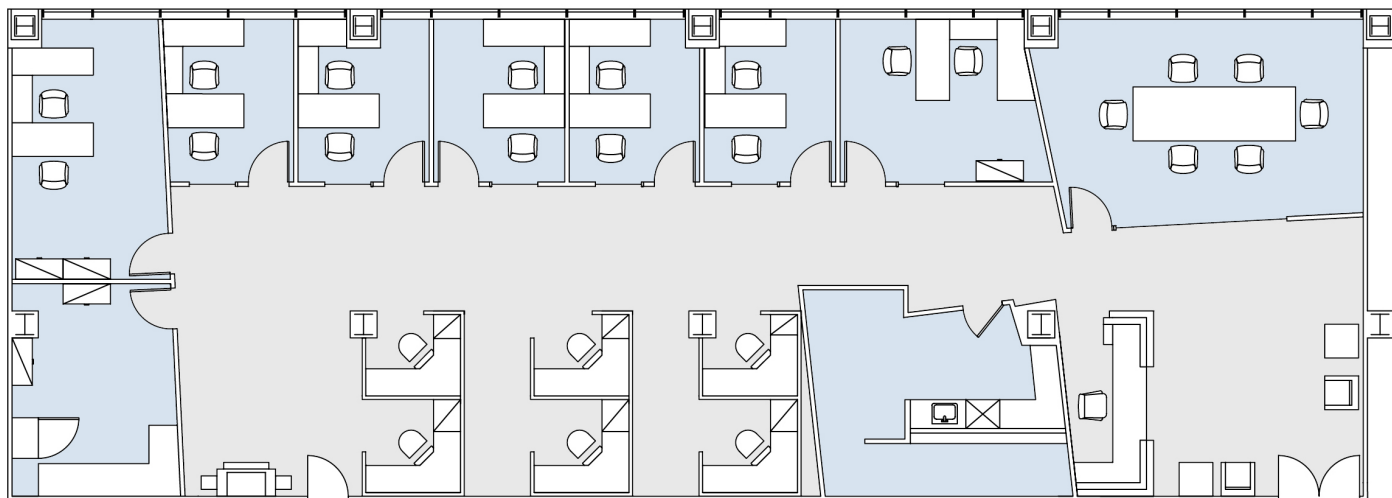

AS-BUILT CONFIGURATION

OFFICES:	7
CONFERENCE ROOMS:	1
RECEPTION AREA:	1
STORAGE ROOM:	1
KITCHEN:	1

ADJUSTED FOR SOCIAL DISTANCING
NOT TO SCALE
FURNITURE NOT INCLUDED

For more information, please contact:

310.255.7777
leasing@douglasemmett.com

**Douglas
Emmett**