
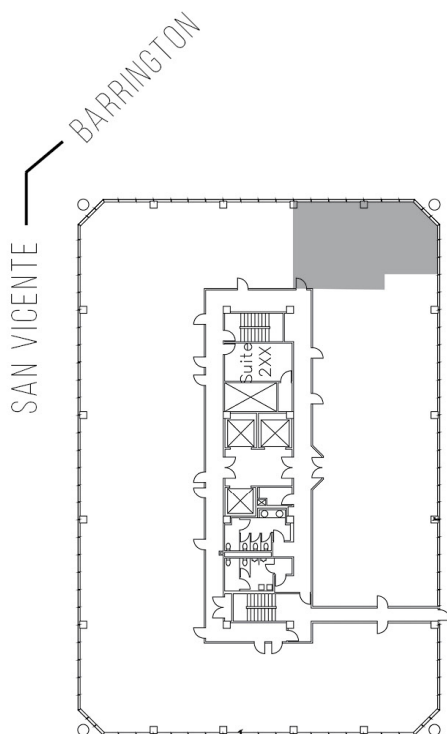


11726 SAN VICENTE

BRENTWOOD EXECUTIVE PLAZA

SUITE 222 | 1,177 RSF

BRENTWOOD-SAN VICENTE

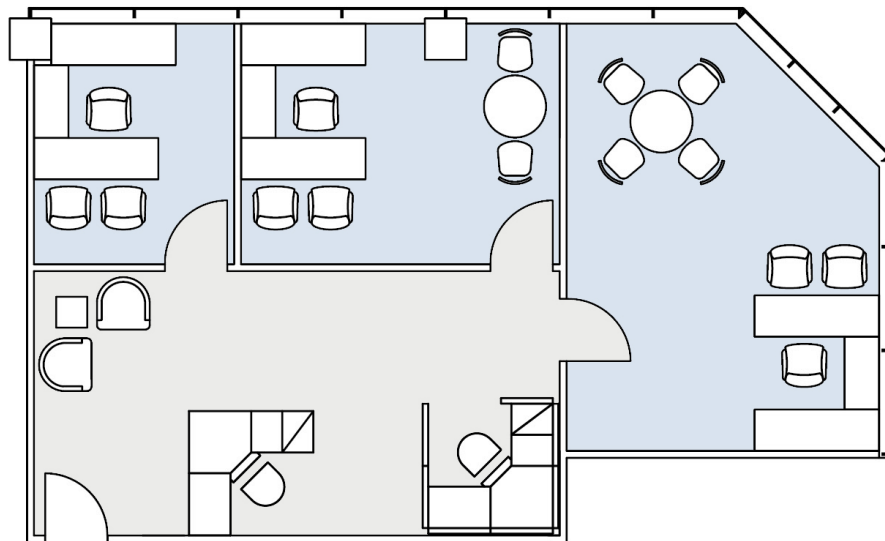

AS-BUILT CONFIGURATION

OFFICES: 3

RECEPTION: 1

NOT TO SCALE
FURNITURE NOT INCLUDED

For more information, please contact:

310.255.7777

leasing@douglasemmett.com

**Douglas
Emmett**