
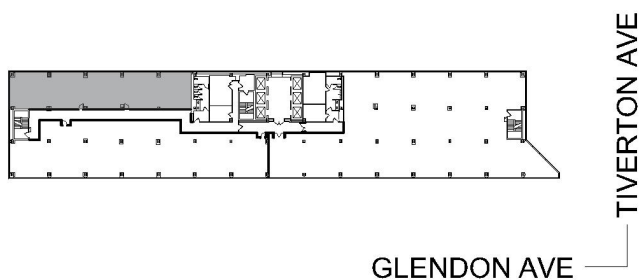


1100 GLENDON AVENUE

WESTWOOD CENTER

SUITE 1840 | 3,516 RSF

WESTWOOD

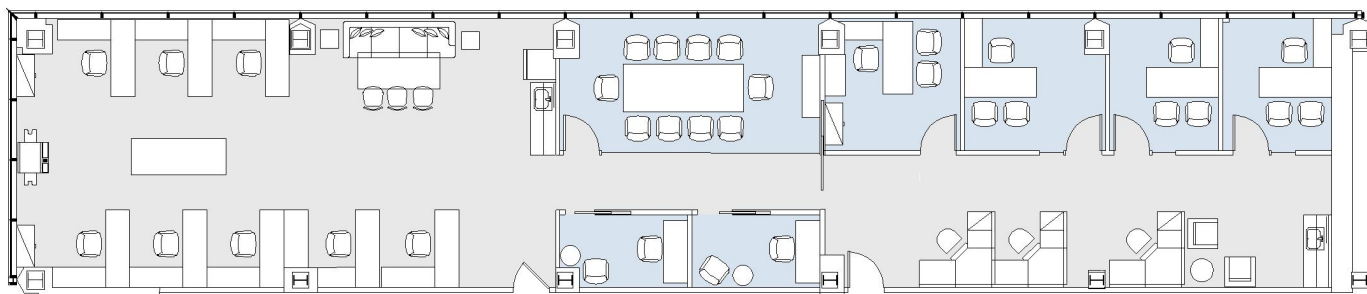

AS-BUILT CONFIGURATION

OFFICES:	4
CONFERENCE ROOM:	1
RECEPTION:	1
KITCHEN:	2
PHONE ROOM:	2

NOT TO SCALE

FURNITURE NOT INCLUDED

For more information, please contact:

310.255.7777

leasing@douglasemmett.com

**Douglas
Emmett**