



6300

THE TRILLIUM - WEST TOWER

SUITE 450 | 1,550 RSF

WOODLAND HILLS

CANOGA AVENUE

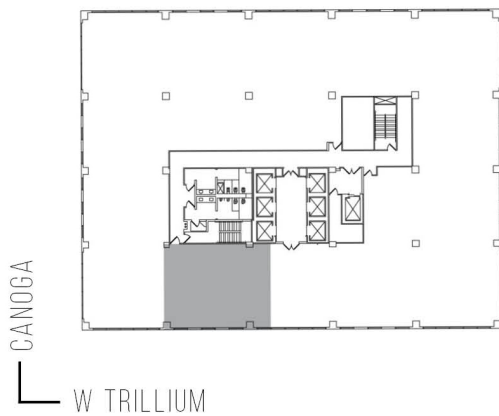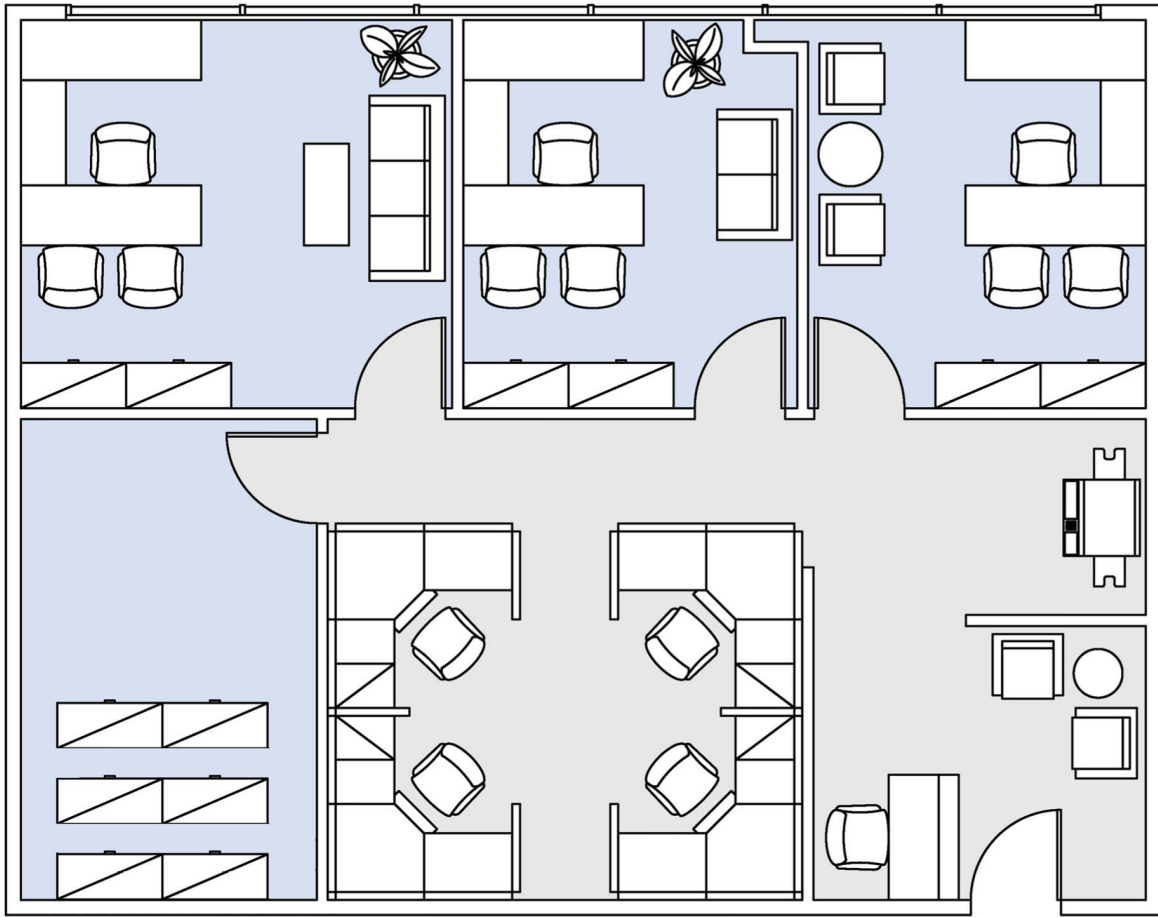

AS-BUILT CONFIGURATION

OFFICES:	3
WORKSTATIONS:	4
RECEPTION:	1
FILE/STORAGE:	1

NOT TO SCALE
FURNITURE NOT INCLUDED

For more information, please contact:

310.255.7777

leasing@douglasemmett.com

**Douglas
Emmett**