
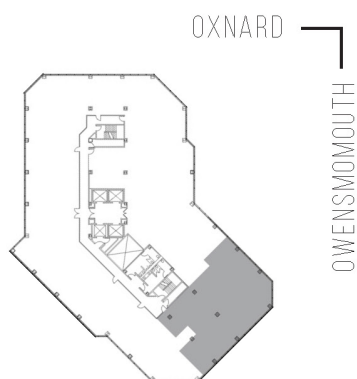


21800
OXNARD STREET

WARNER CENTER TOWER - V

SUITE 905 | 3,707 RSF

WOODLAND HILLS

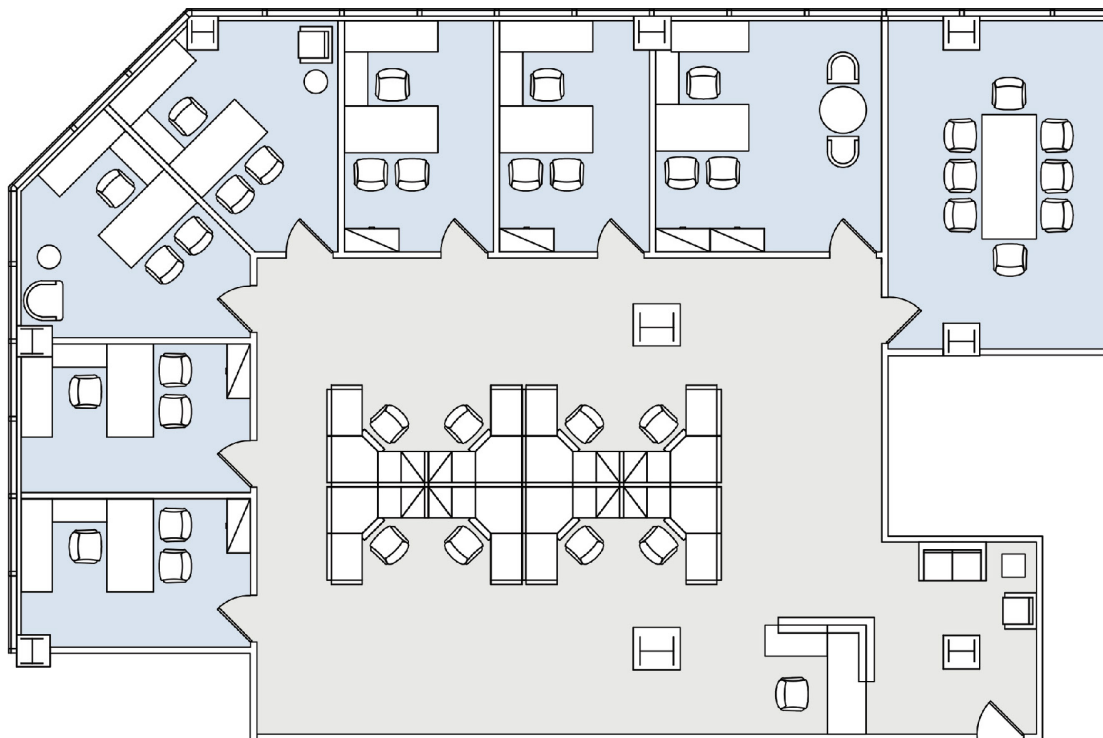

AS-BUILT CONFIGURATION

OFFICES:	7
RECEPTION:	1
CONFERENCE ROOM:	1

NOT TO SCALE
FURNITURE NOT INCLUDED

For more information, please contact:

310.255.7777

leasing@douglasemmett.com

**Douglas
Emmett**