



11999

BRENTWOOD/SALTAIR

SUITE 290 | 6,259 RSF

BRENTWOOD-SAN VICENTE

SAN VICENTE

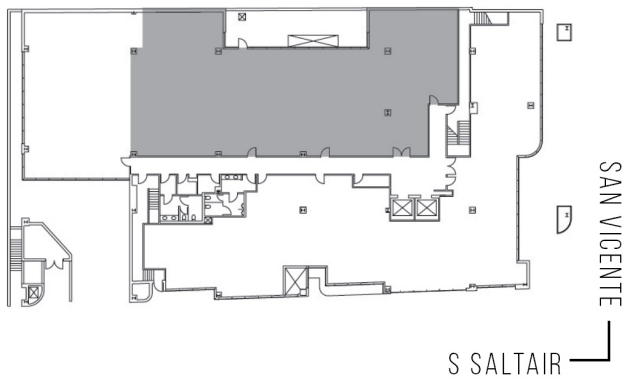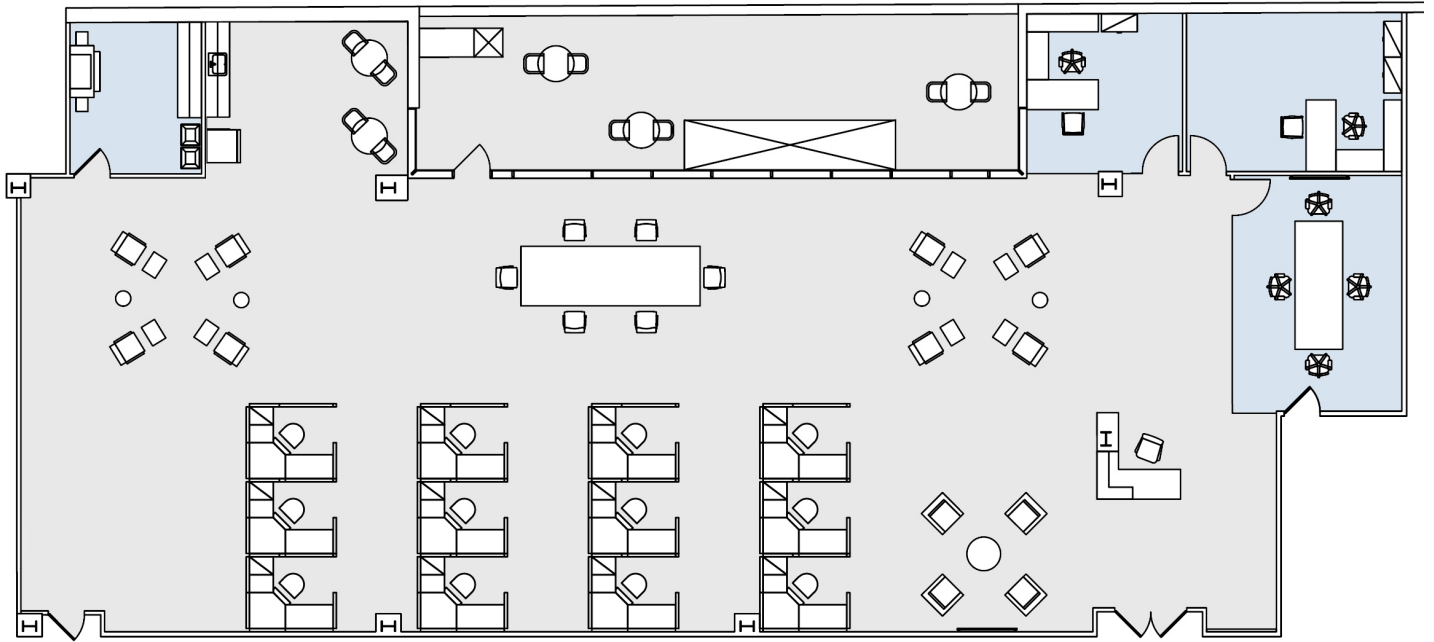

AS-BUILT CONFIGURATION

OFFICES:	2
CONFERENCE ROOM:	1
RECEPTION:	1
OPEN KITCHEN:	1
PATIO:	1
COPY ROOM:	1

ADJUSTED FOR SOCIAL DISTANCING
NOT TO SCALE
FURNITURE NOT INCLUDED

For more information, please contact:

310.255.7777

leasing@douglasemmett.com

**Douglas
Emmett**