
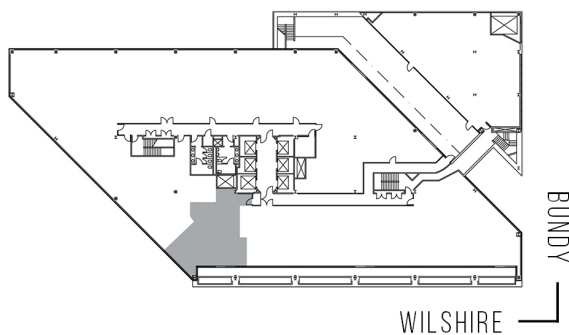


12121 WILSHIRE

WILSHIRE BUNDY PLAZA

SUITE 215 | 1,512 RSF

BRENTWOOD-WILSHIRE

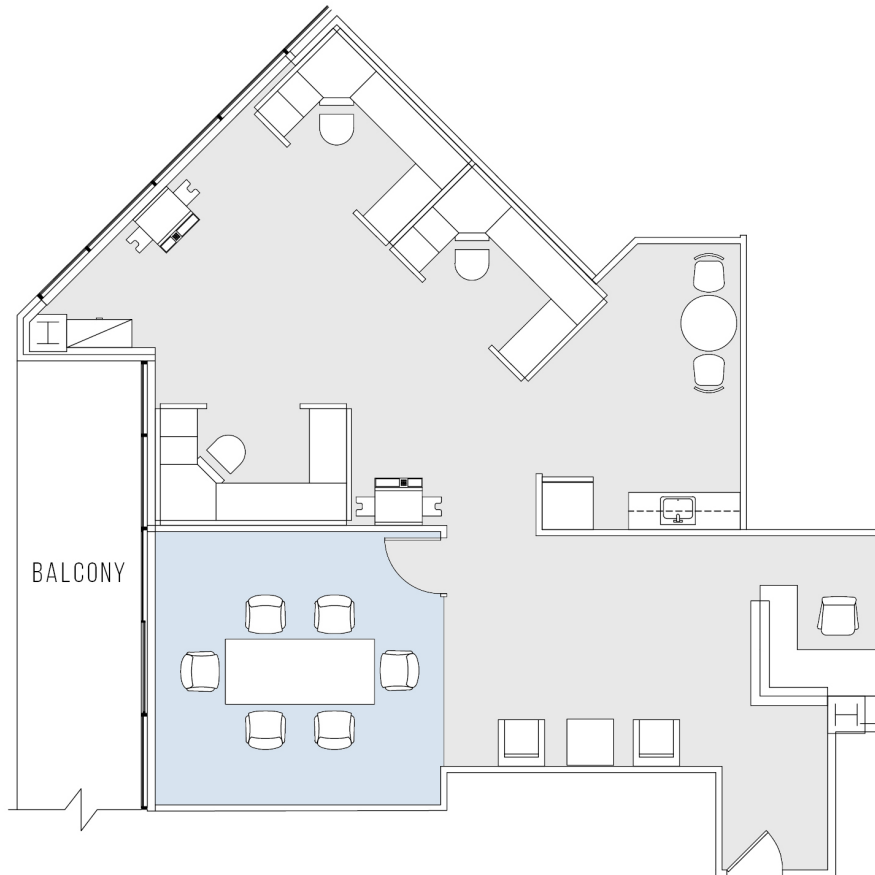

AS-BUILT CONFIGURATION

CONFERENCE ROOM:	1
RECEPTION:	1
KITCHEN:	1

ADJUSTED FOR SOCIAL DISTANCING

NOT TO SCALE
FURNITURE NOT INCLUDED

For more information, please contact:

310.255.7777

leasing@douglasemmett.com

**Douglas
Emmett**