
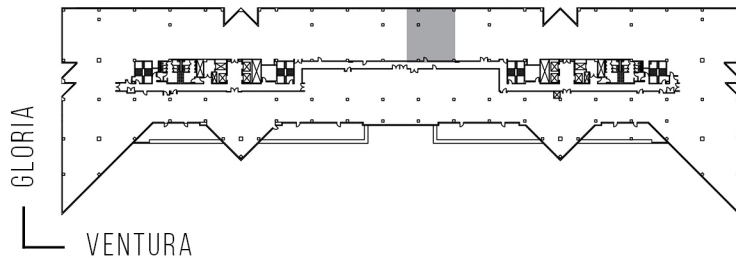


15821 VENTURA

ENCINO TERRACE

SUITE 540 | 2,320 RSF

SHERMAN OAKS/ENCINO

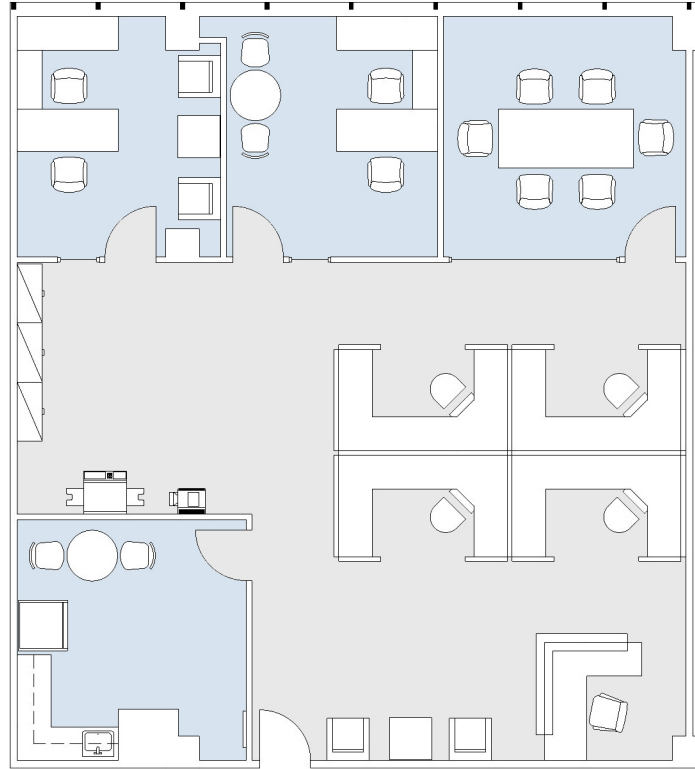

AS-BUILT CONFIGURATION

| | |
|------------------|---|
| OFFICES: | 2 |
| CONFERENCE ROOM: | 1 |
| RECEPTION: | 1 |
| KITCHEN: | 1 |

ADJUSTED FOR SOCIAL DISTANCING
NOT TO SCALE
FURNITURE NOT INCLUDED

For more information, please contact:

310.255.7777
leasing@douglasemmett.com

**Douglas
Emmett**