
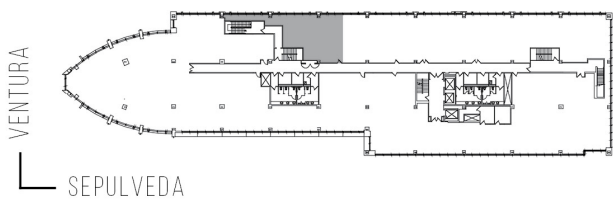


15301 VENTURA

SOG-GARDEN OFFICE BUILDING

SUITE 330 | 1,685 RSF

SHERMAN OAKS/ENCINO

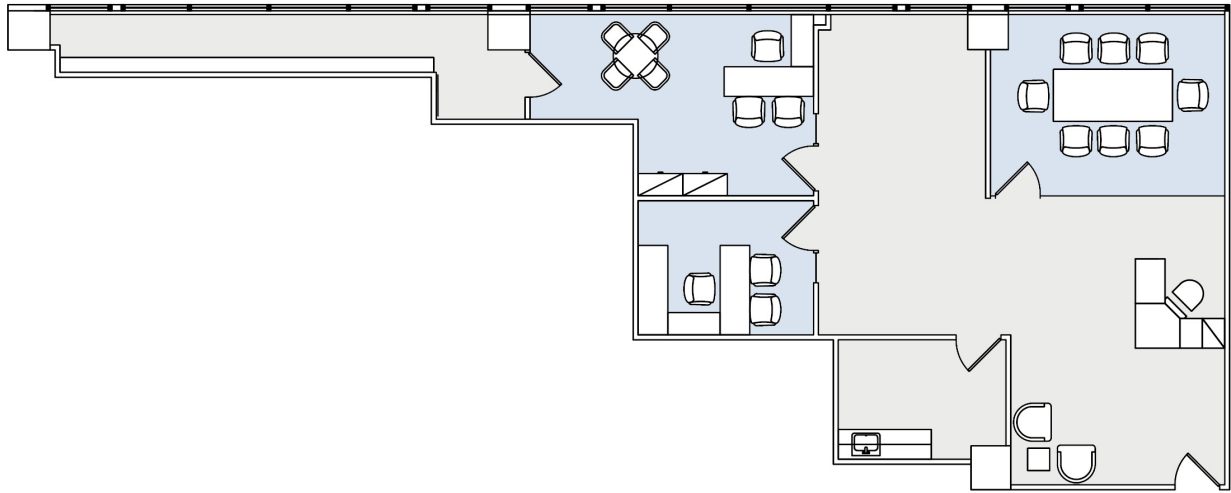

AS-BUILT CONFIGURATION

| | |
|----------------------|---|
| OFFICES: | 2 |
| CONFERENCE ROOM: | 1 |
| RECEPTION: | 1 |
| SERVER/STORAGE ROOM: | 1 |
| KITCHEN: | 1 |

NOT TO SCALE
FURNITURE NOT INCLUDED

For more information, please contact:

310.255.7777

leasing@douglasemmett.com

**Douglas
Emmett**