
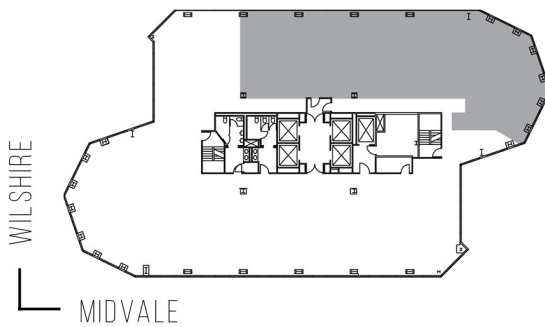


10940 WILSHIRE

THE TOWER

SUITE 1400 | 4,412 RSF

WESTWOOD

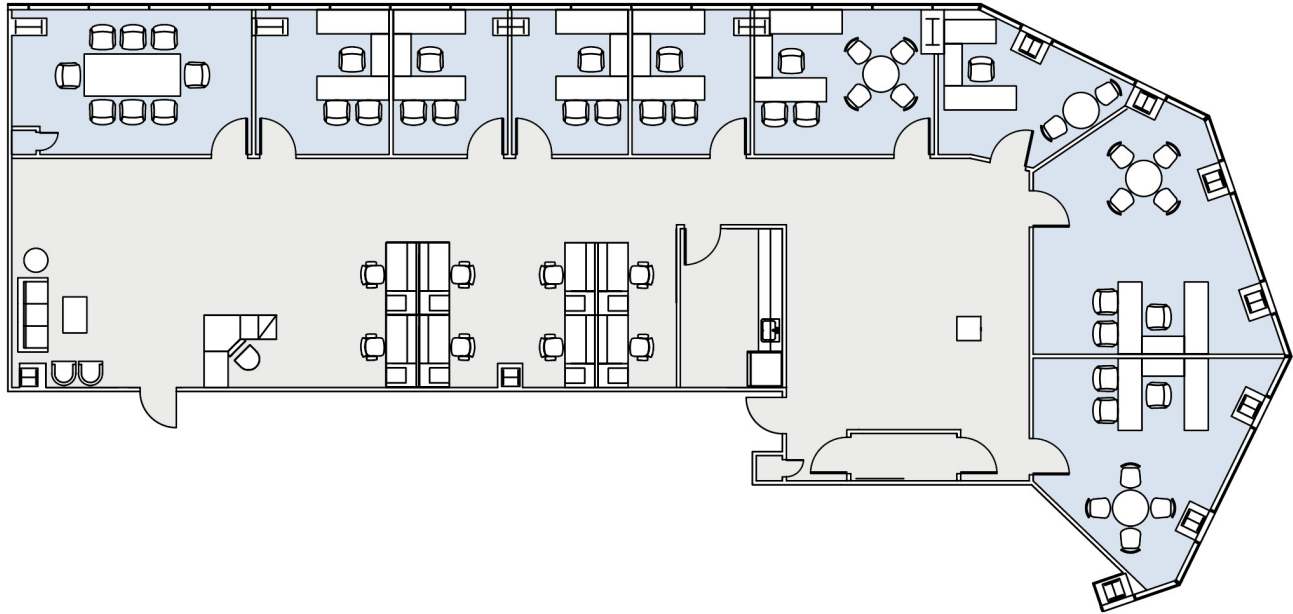

AS-BUILT CONFIGURATION

OFFICES:	8
CONFERENCE ROOM:	1
RECEPTION AREA:	1
SERVER ROOM:	1
STORAGE CLOSET:	2
KITCHEN:	1

NOT TO SCALE
FURNITURE NOT INCLUDED

For more information, please contact:

310.255.7777

leasing@douglasemmett.com

**Douglas
Emmett**