



1001

BISHOP SQUARE - ASB TOWER

SUITE 710 | 1,916 RSF

HONOLULU

BISHOP STREET

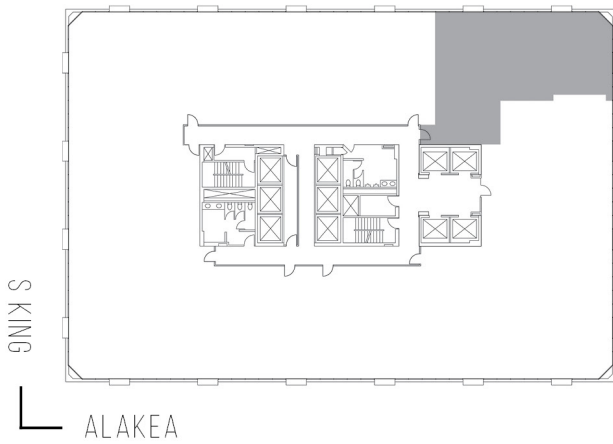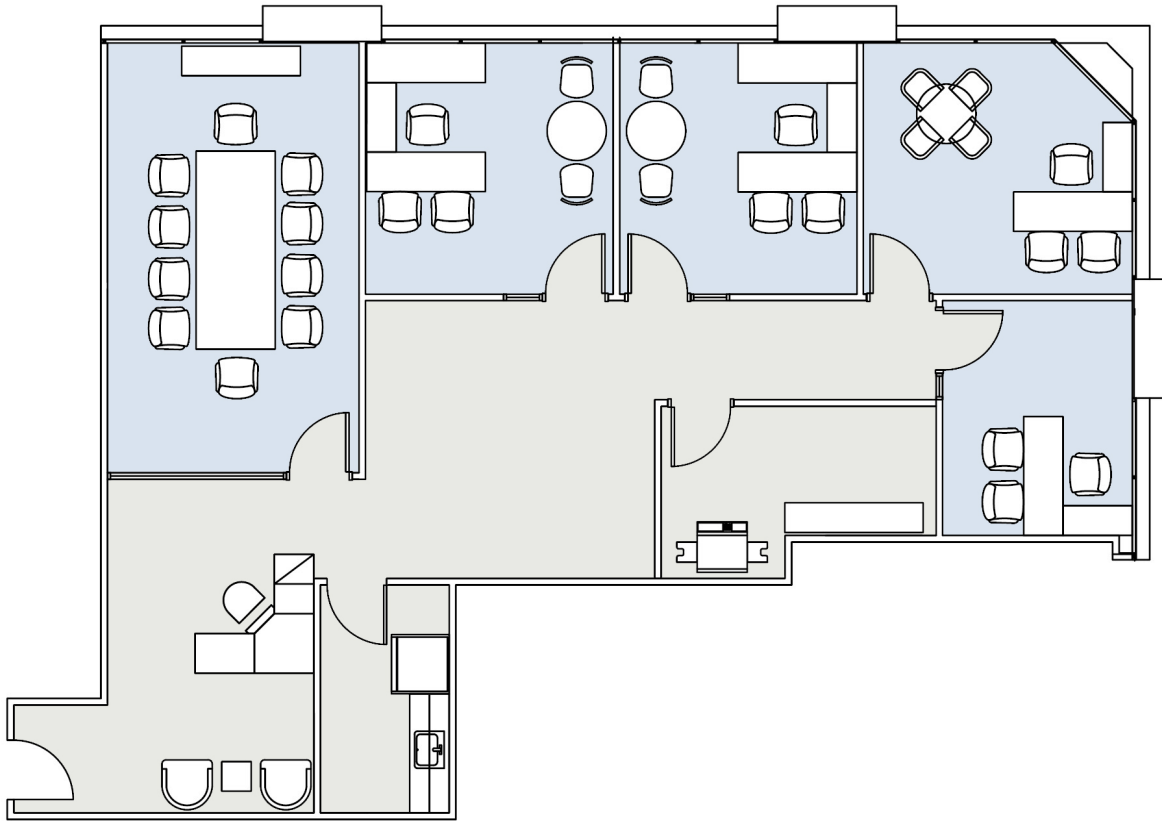

AS-BUILT CONFIGURATION

OFFICES:	4
CONFERENCE ROOM:	1
KITCHEN:	1
RECEPTION:	1
COPY/STORAGE ROOM:	1

NOT TO SCALE
FURNITURE NOT INCLUDED

For more information, please contact:

310.255.7777

leasing@douglasemmett.com

**Douglas
Emmett**