


12121 WILSHIRE

WILSHIRE BUNDY PLAZA

SUITE 350 | 4,693 RSF

BRENTWOOD-WILSHIRE

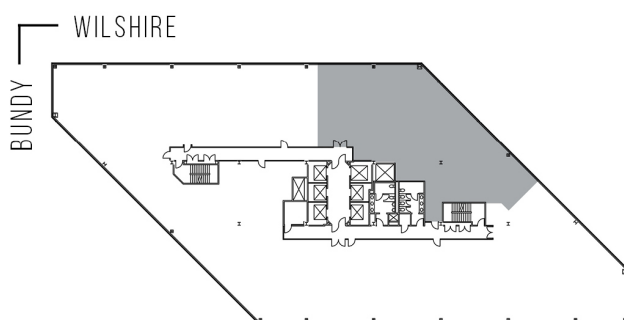

AS-BUILT CONFIGURATION

OFFICES:	9
CONFERENCE ROOM:	1
RECEPTION:	1
KITCHEN:	1
I.T. CLOSET:	1

ADJUSTED FOR SOCIAL DISTANCING
NOT TO SCALE
FURNITURE NOT INCLUDED

For more information, please contact:

310.255.7777
leasing@douglasemmett.com

**Douglas
Emmett**