
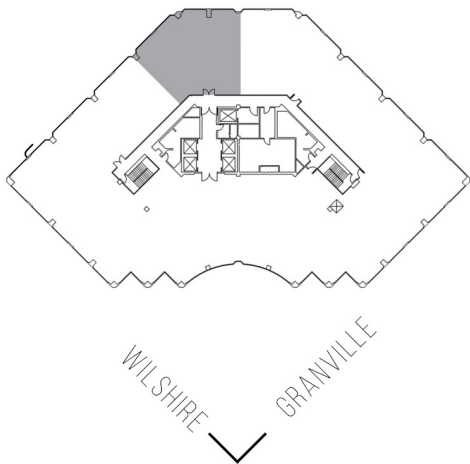


11766 WILSHIRE

LANDMARK II

SUITE 1450 | 2,522 RSF

BRENTWOOD-WILSHIRE

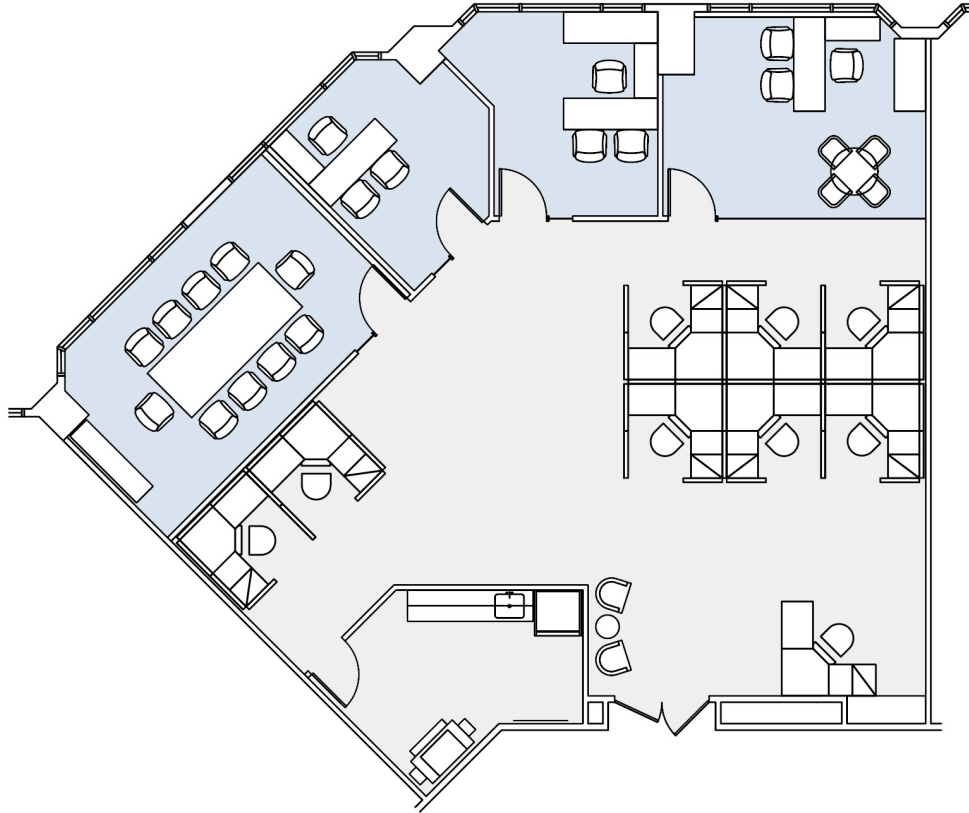

AS-BUILT CONFIGURATION

OFFICES:	3
CONFERENCE ROOM:	1
RECEPTION AREA:	1
KITCHEN:	1

NOT TO SCALE
FURNITURE NOT INCLUDED

For more information, please contact:

310.255.7777
leasing@douglasemmett.com

**Douglas
Emmett**