
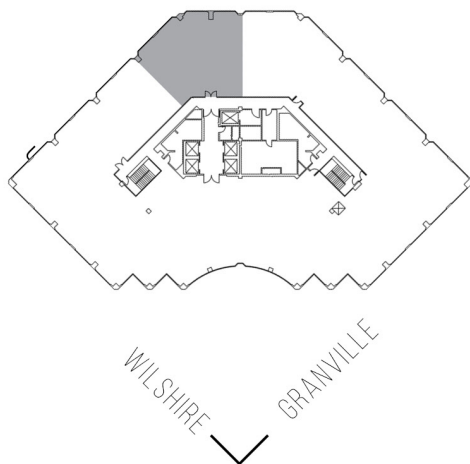


# 11766 WILSHIRE

THE LANDMARK TWO

SUITE 1450 | 2,522 RSF

BRENTWOOD-WILSHIRE

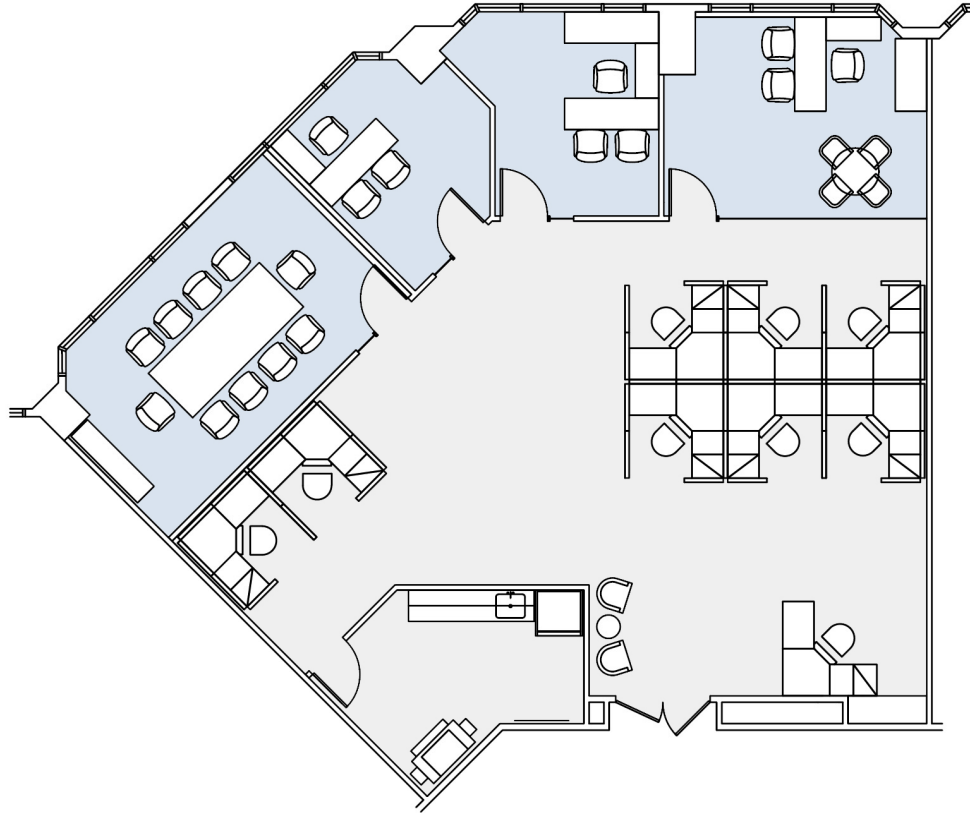

#### AS-BUILT CONFIGURATION

|                  |   |
|------------------|---|
| OFFICES:         | 3 |
| CONFERENCE ROOM: | 1 |
| RECEPTION AREA:  | 1 |
| KITCHEN:         | 1 |

NOT TO SCALE  
FURNITURE NOT INCLUDED

For more information, please contact:

310.255.7777  
leasing@douglasemmett.com

**Douglas  
Emmett**