
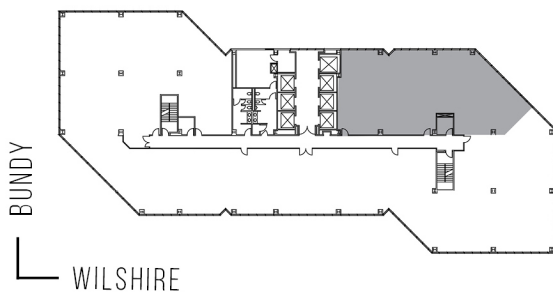


# 12100 WILSHIRE

SUITE 550 | 4,039 RSF  
BRENTWOOD-WILSHIRE

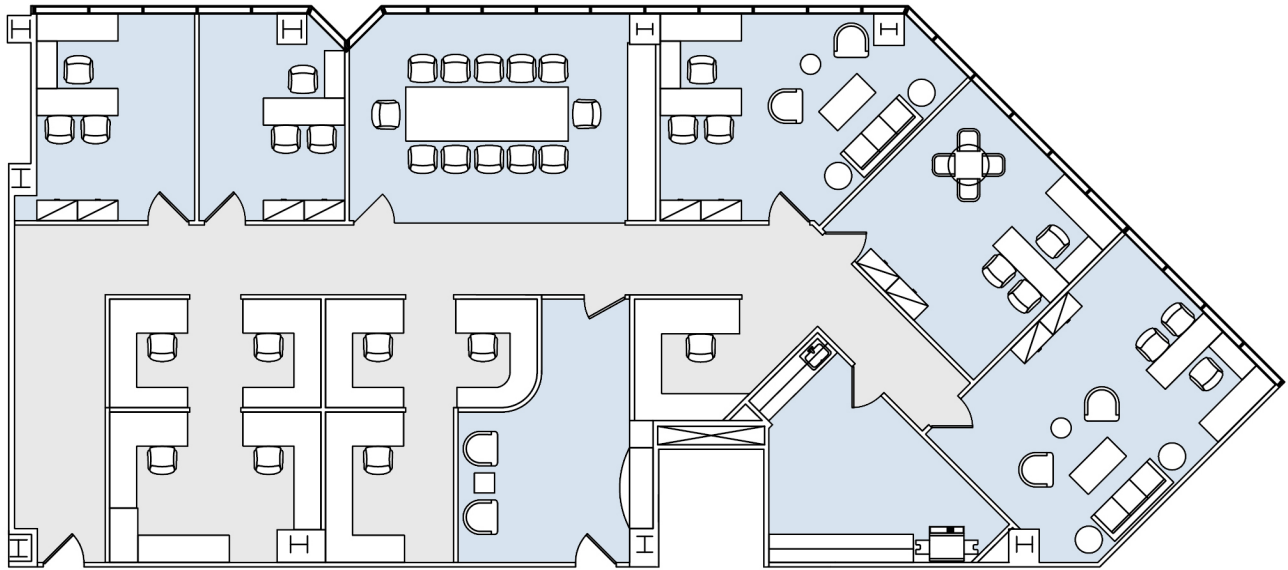

#### AS-BUILT CONFIGURATION

OFFICES:	5
CONFERENCE ROOM:	1
RECEPTION:	1
KITCHEN:	1
TELEPHONE CLOSET:	1

NOT TO SCALE  
FURNITURE NOT INCLUDED

For more information, please contact:

310.255.7777  
leasing@douglasemmett.com

**Douglas  
Emmett**