
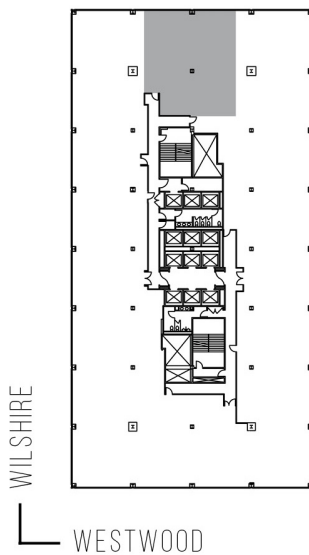


# 10880 WILSHIRE

SUITE 870 | 2,858 RSF

WESTWOOD

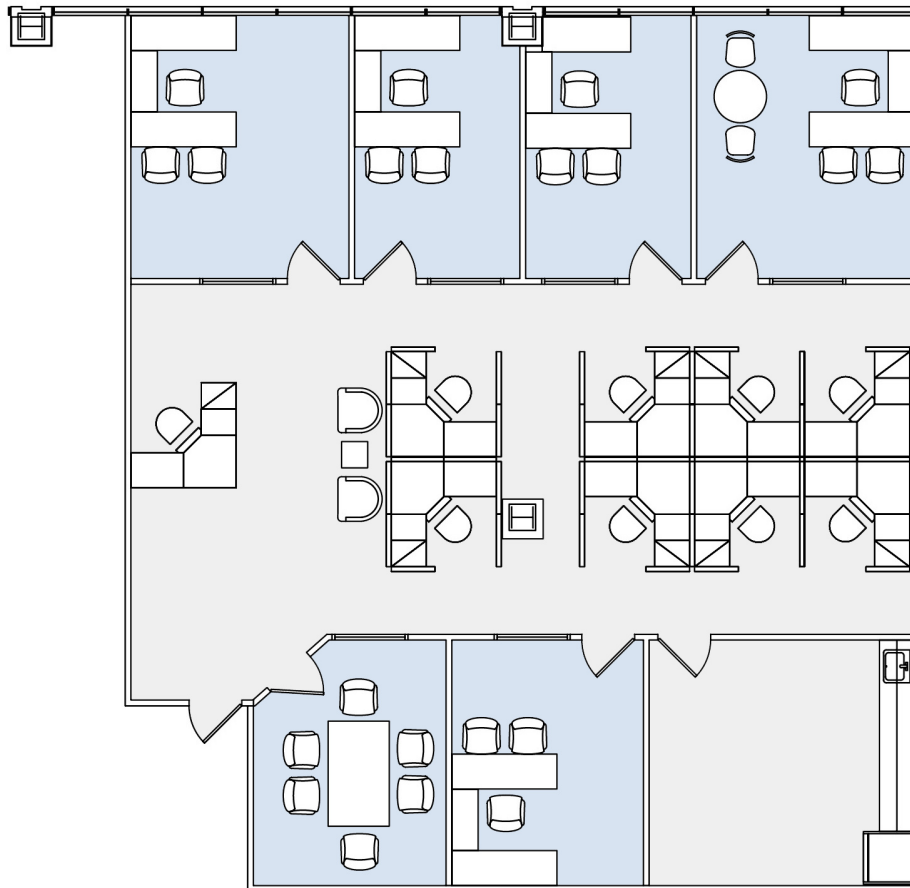

#### AS-BUILT CONFIGURATION

OFFICES:	5
RECEPTION:	1
CONFERENCE ROOM:	1
KITCHEN:	1

NOT TO SCALE  
FURNITURE NOT INCLUDED

For more information, please contact:

310.255.7777

leasing@douglasemmett.com

**Douglas  
Emmett**