
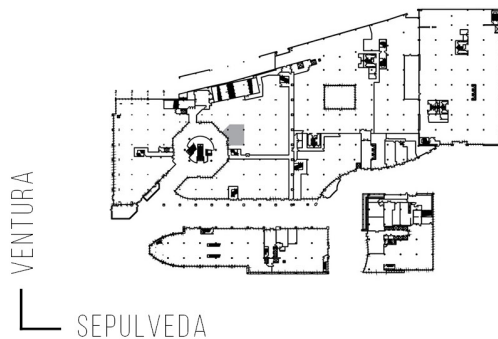


15301
VENTURA

SOG-RETAIL BUILDING

SUITE P36 | 1,463 RSF

SHERMAN OAKS/ENCINO

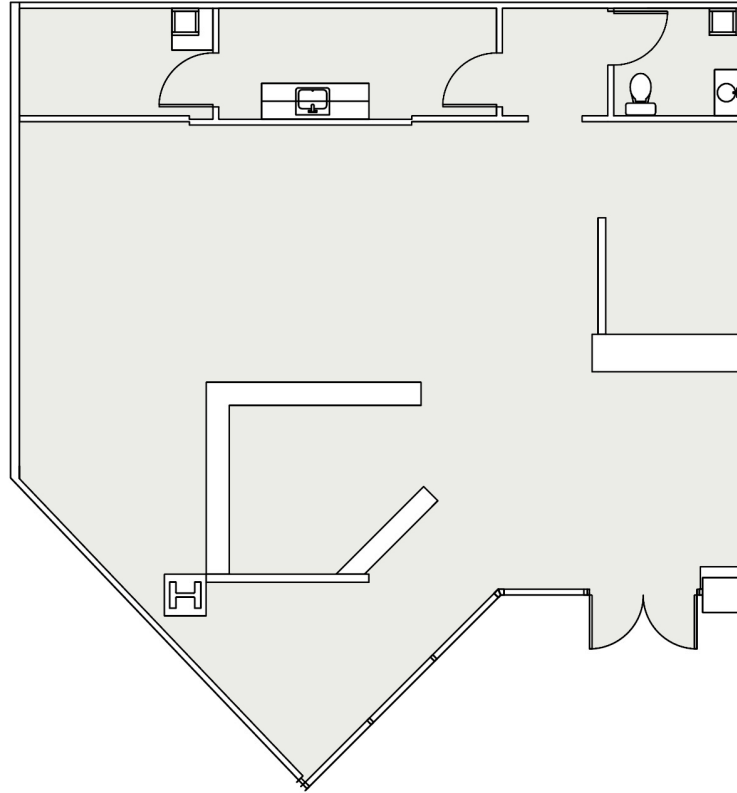

AS-BUILT CONFIGURATION

NOT TO SCALE
FURNITURE NOT INCLUDED

For more information, please contact:

310.255.7777
leasing@douglasemmett.com

**Douglas
Emmett**