
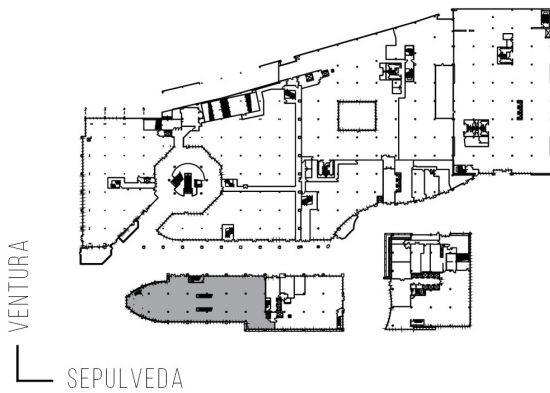


# 15301 VENTURA

SOG-RETAIL BUILDING

SUITE P23 | 16,195 RSF

SHERMAN OAKS/ENCINO

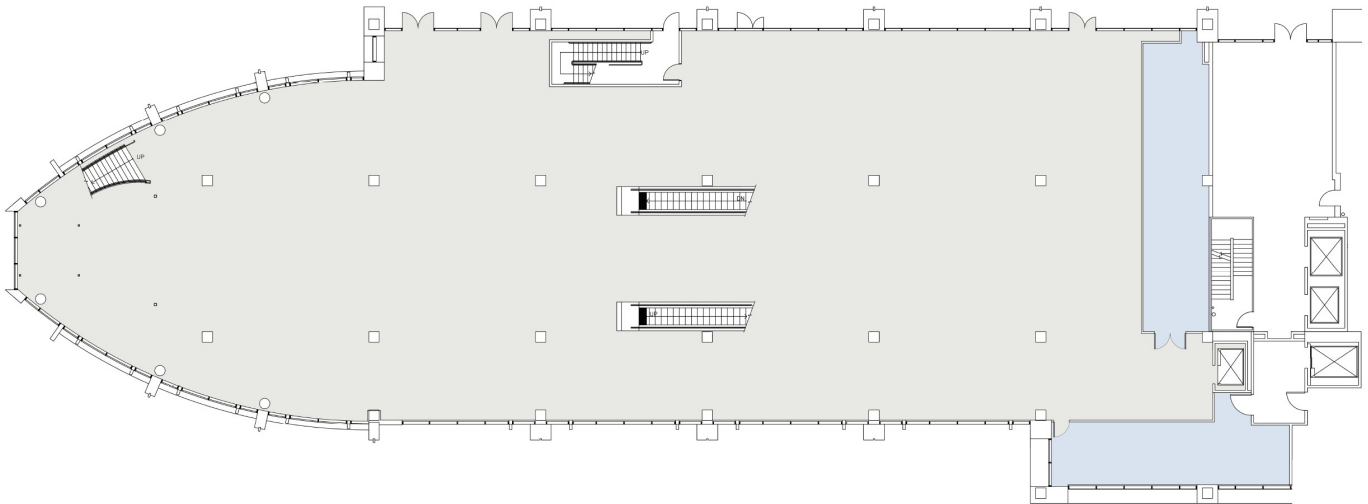

AS-BUILT CONFIGURATION

NOT TO SCALE

For more information, please contact:

310.255.7777

leasing@douglasemmett.com

**Douglas  
Emmett**